


T. 1 S., R. 2 W., W. M.

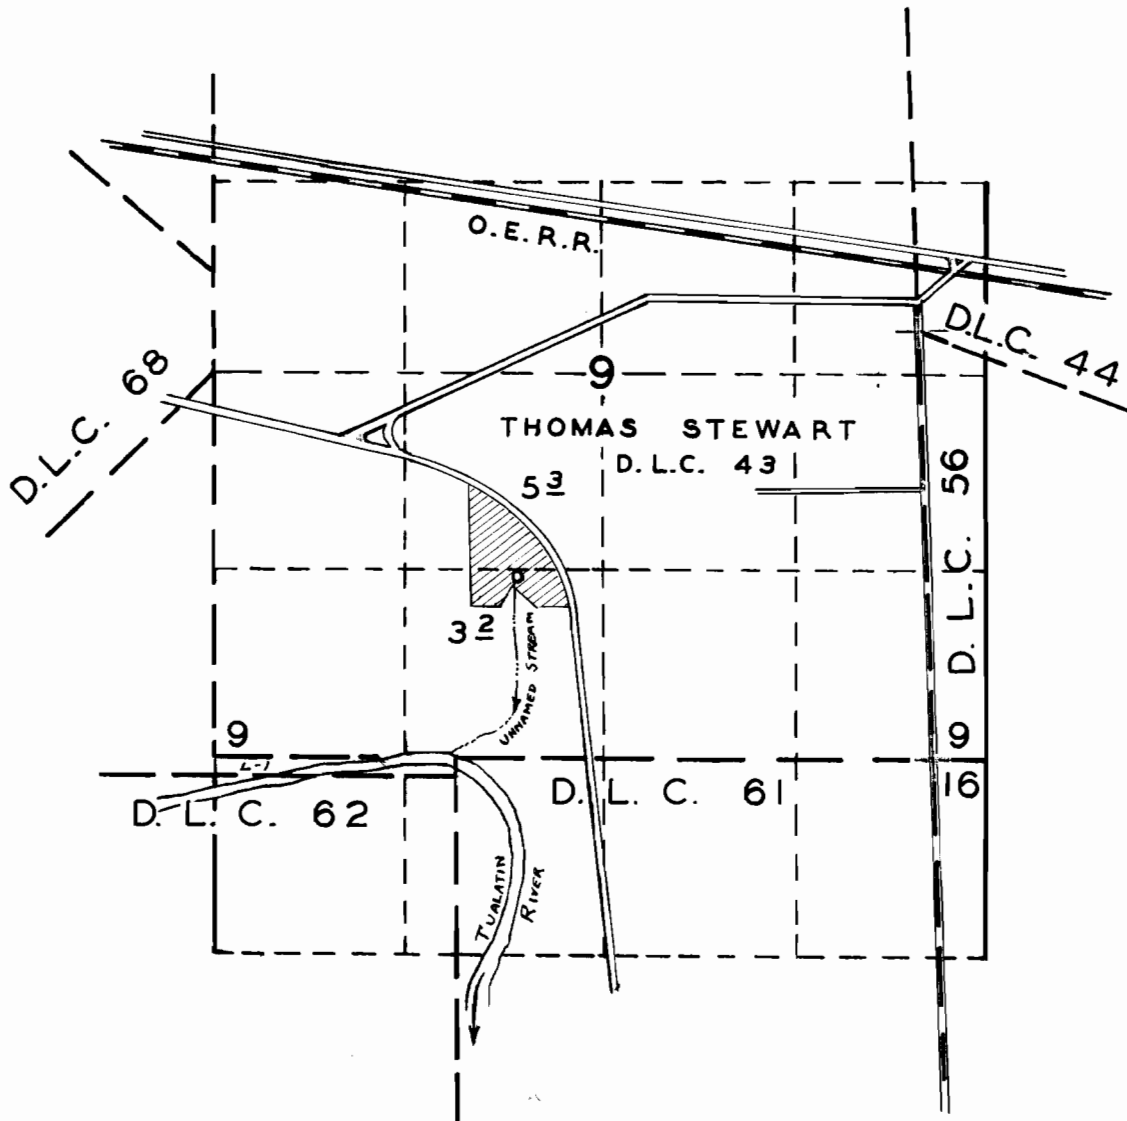

FINAL PROOF SURVEY

UNDER

Application No. 28486 Permit No. 22406

IN NAME OF

ODLAT R. MERRILL

Surveyed 4 - 23 1956, by M. BISH