


T. I S. R. 3 E. W. M.

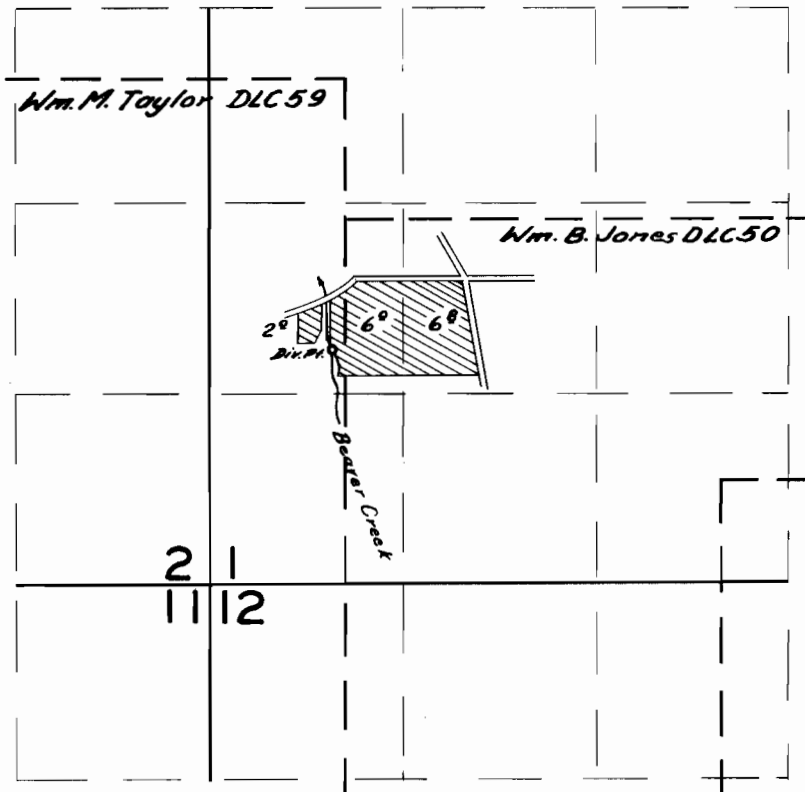

**FINAL PROOF SURVEY**  
UNDER

Application No. 28609 Permit No. 22537  
IN NAME OF

.....No. 61 ASAKAWA.....

Surveyed June 26, 1956, by R. H. Whitby.

DFO-50-22