


T. 1 S. R. 3 E. W. M.

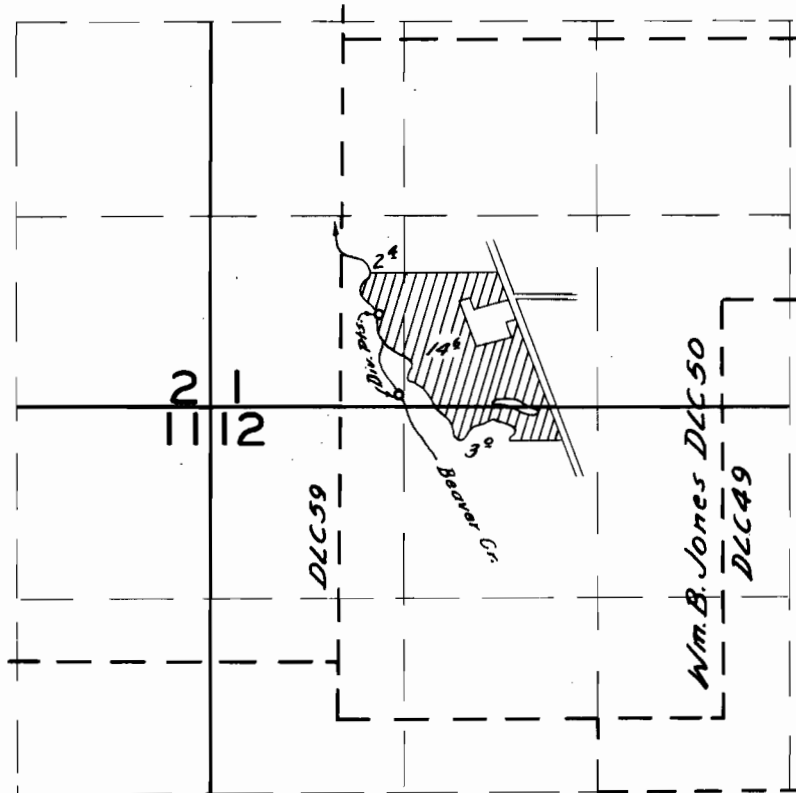

FINAL PROOF SURVEY

UNDER

Application No. *28610* Permit No. *22538*

IN NAME OF

CORBETT HOPKINS

Surveyed *June 27, 1956*, by *R.H. Whitby*

DFO-5D-22