


T. 1 & 2 N., R. 2 W., W.M.

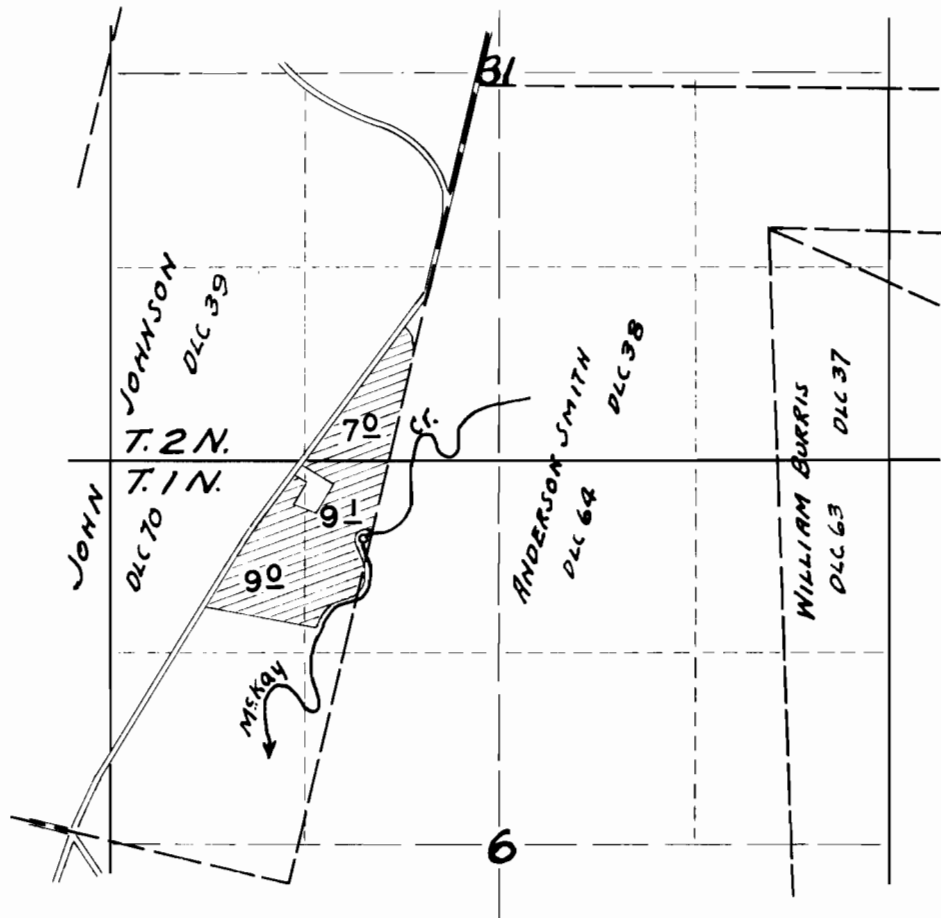

**FINAL PROOF SURVEY**

UNDER

Application No. 28721 Permit No. 22648

IN NAME OF

EDGAR E. MILLER

Surveyed 4 - 12 1956, by M. BISH