


T. 1 S., R. 2 & 3 W., W. M.

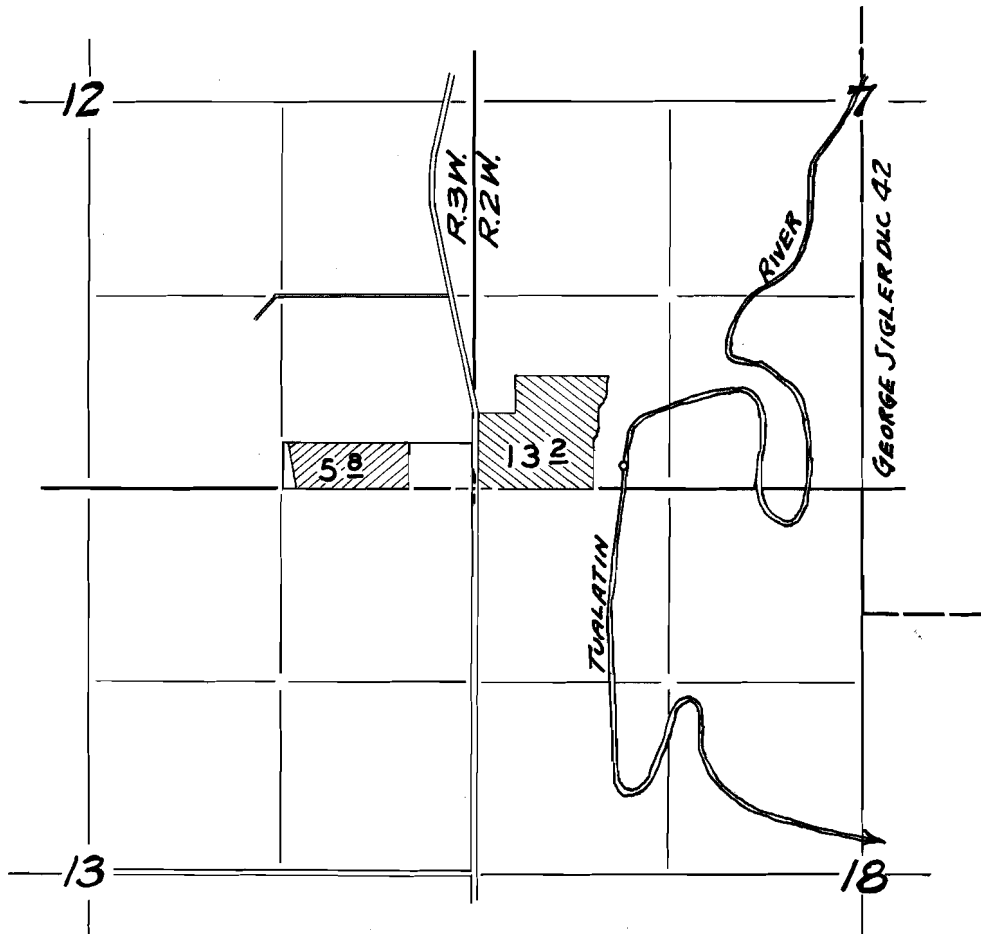

FINAL PROOF SURVEY

UNDER
27720 21834
Application No. 28778 Permit No. 22655



IN NAME OF

..... ROSS A. FURBY

Surveyed 4 - 25 1956, by M. BISH