


T. 9 S. R. 1 W. W. M.

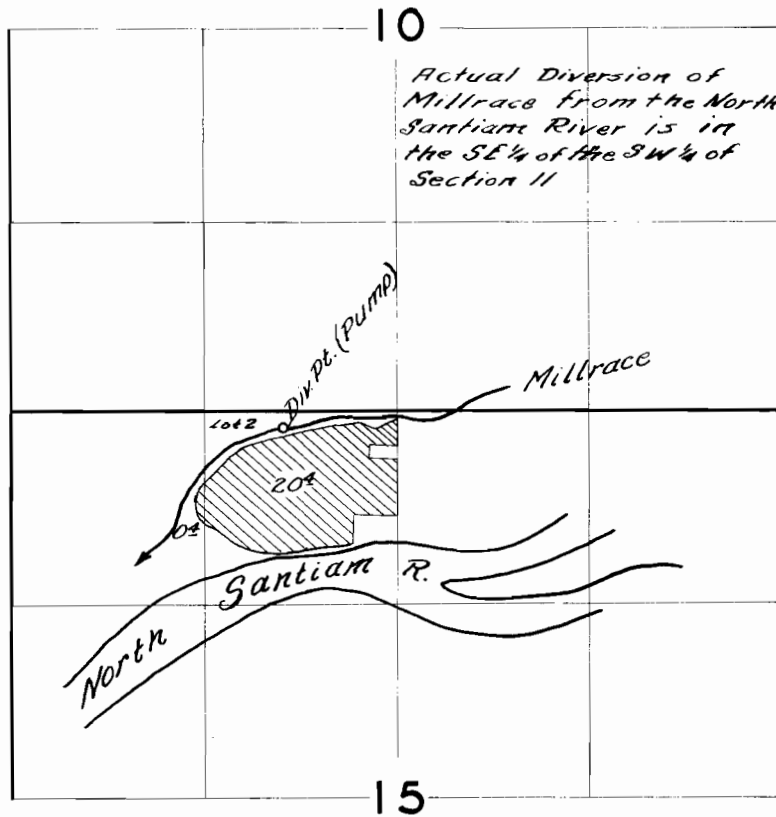

**FINAL PROOF SURVEY**  
UNDER

Application No. 29065 Permit No. 22860  
IN NAME OF

*C. H. & Wanda Jean Darley*

Surveyed *May 16, 1956*, by *R. H. Whitby*.

DFN-10-48