


T. 2 S., R. 2 W., W.M.

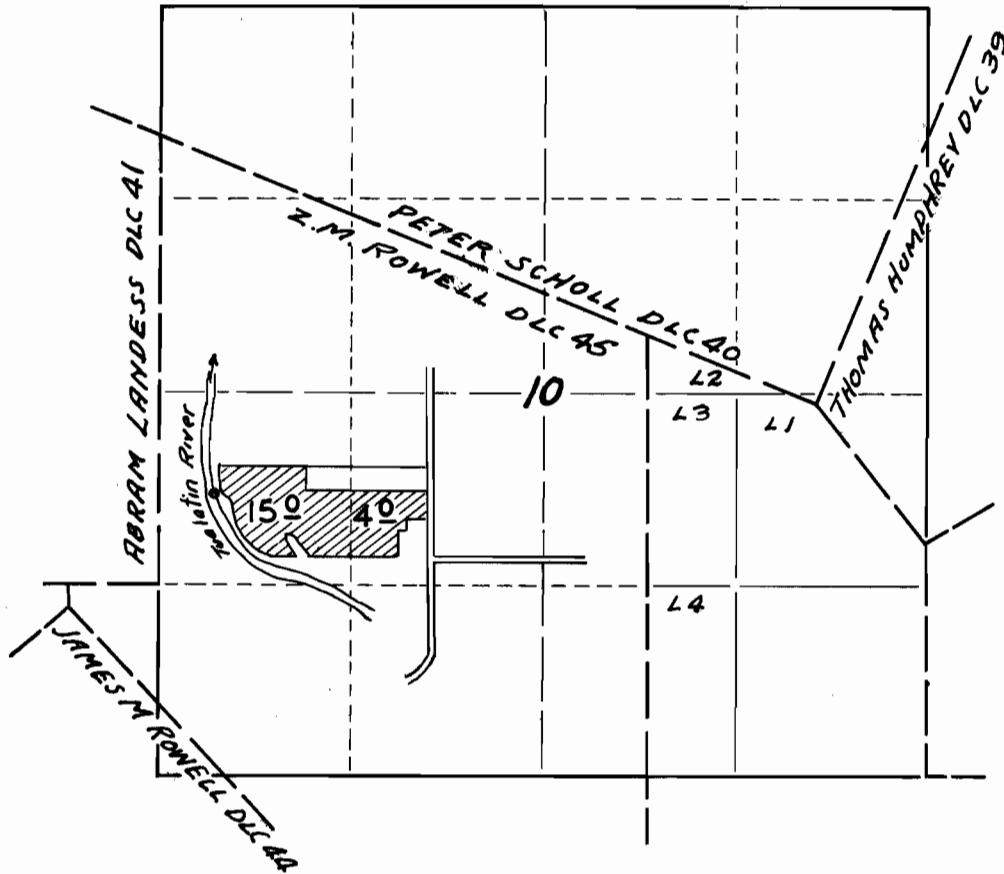

**FINAL PROOF SURVEY**

UNDER

Application No. 29196 Permit No. 22948

IN NAME OF

LLOYD A. PETRIE

Surveyed 4 - 26 1956 by M. BISH