


T. 7N. R. 3W. W. M.

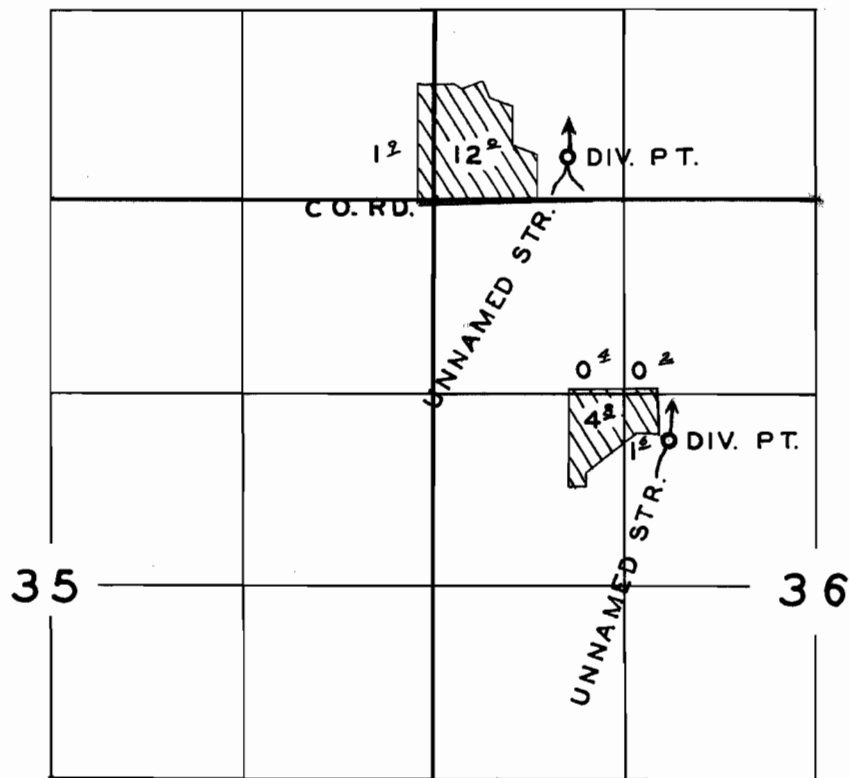

FINAL PROOF SURVEY
UNDER

Application No. 2918.4 Permit No. 23112
IN NAME OF

HERMAN PELLHAM

Surveyed AUG. 25 1956, by R. H. WHITBY