


T. 1 N. R. 3 W. W.M.

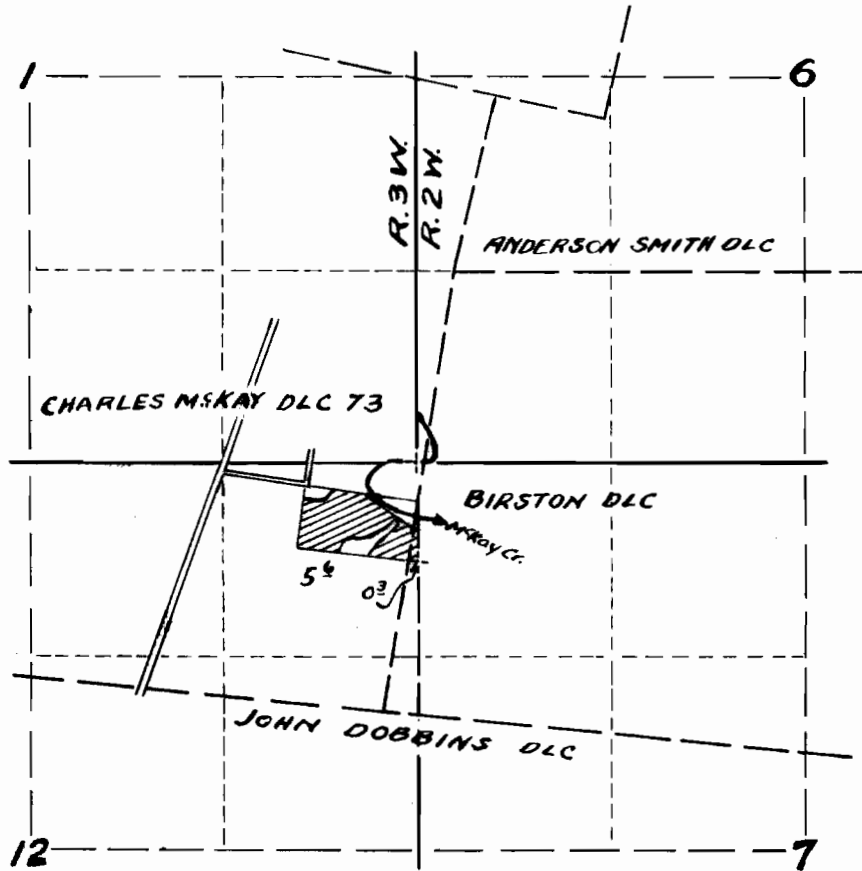

FINAL PROOF SURVEY

UNDER

Application No. 29459 Permit No. 23184

IN NAME OF

J. W. THOMAS

Surveyed 4-23 1956, by R. H. WHITBY