


T. 2S. R. 1&2E. W.M.

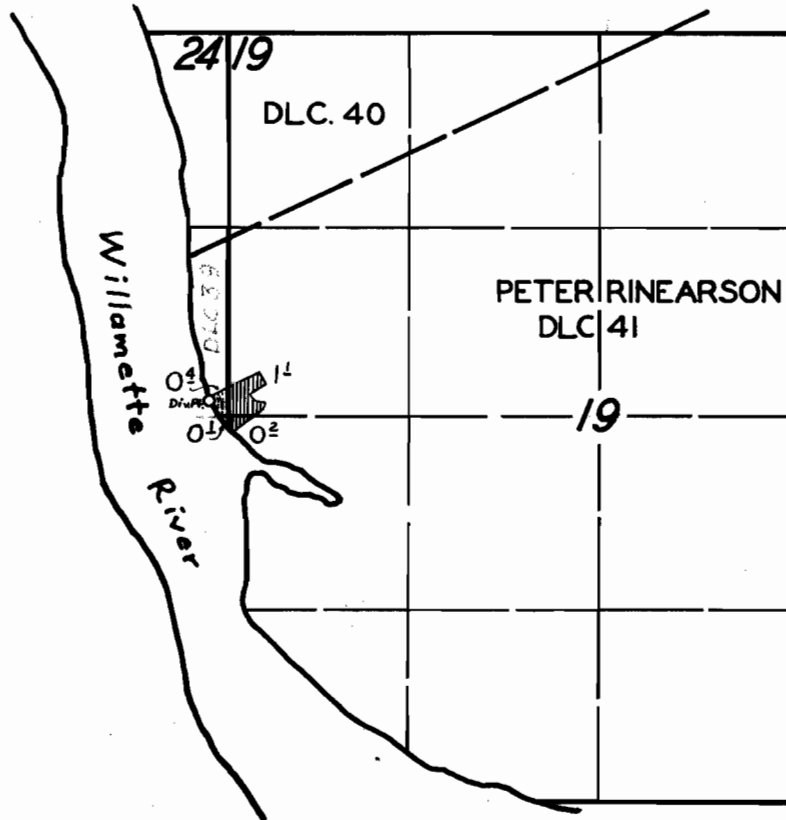

FINAL PROOF SURVEY
UNDER

Application No. 29489 Permit No. 23189
IN NAME OF

RICHARD J. & HELEN M. HOPKINS

Surveyed 3 Aug. 1956, by M. Bish