


T. 1 S., R. 2 & 3 W., W.M.

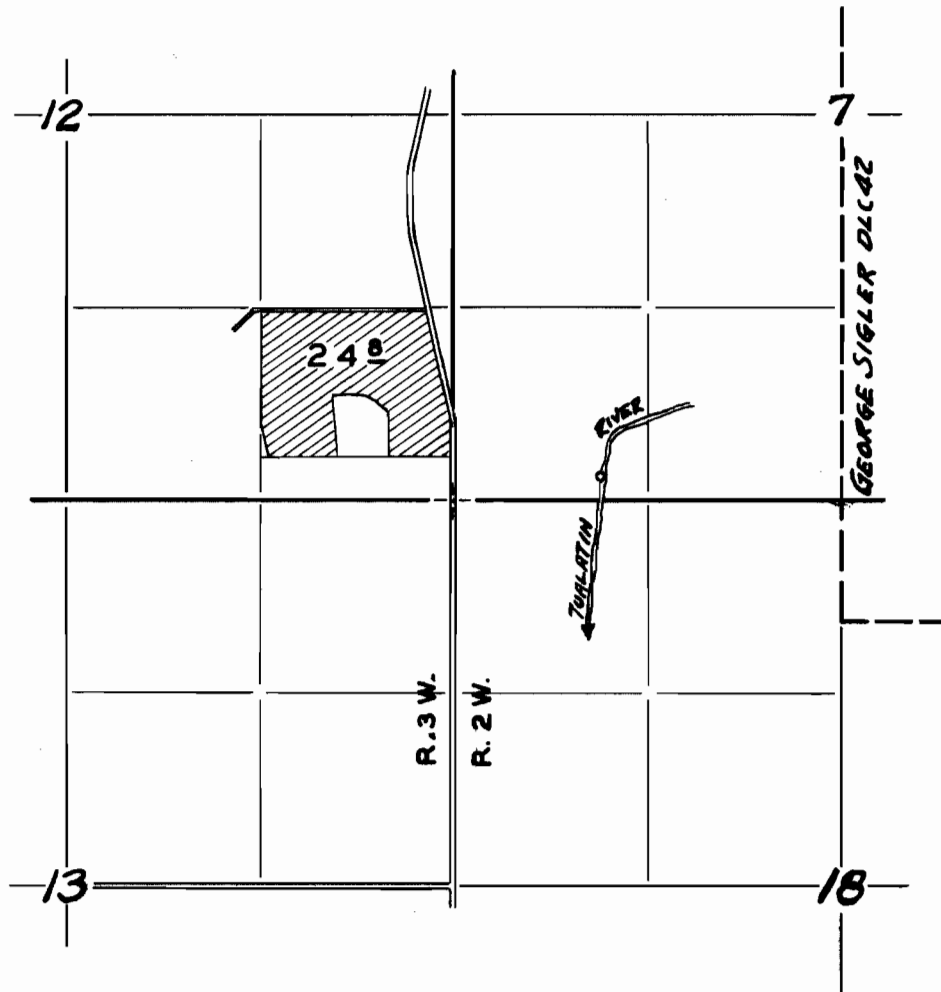

FINAL PROOF SURVEY

UNDER

Application No. 29471 Permit No. 23242

IN NAME OF

DONALD C. & JEAN JESSE

Surveyed 4 - 25 1956, by M. BISH