


T.2S. R.3E.W.M.

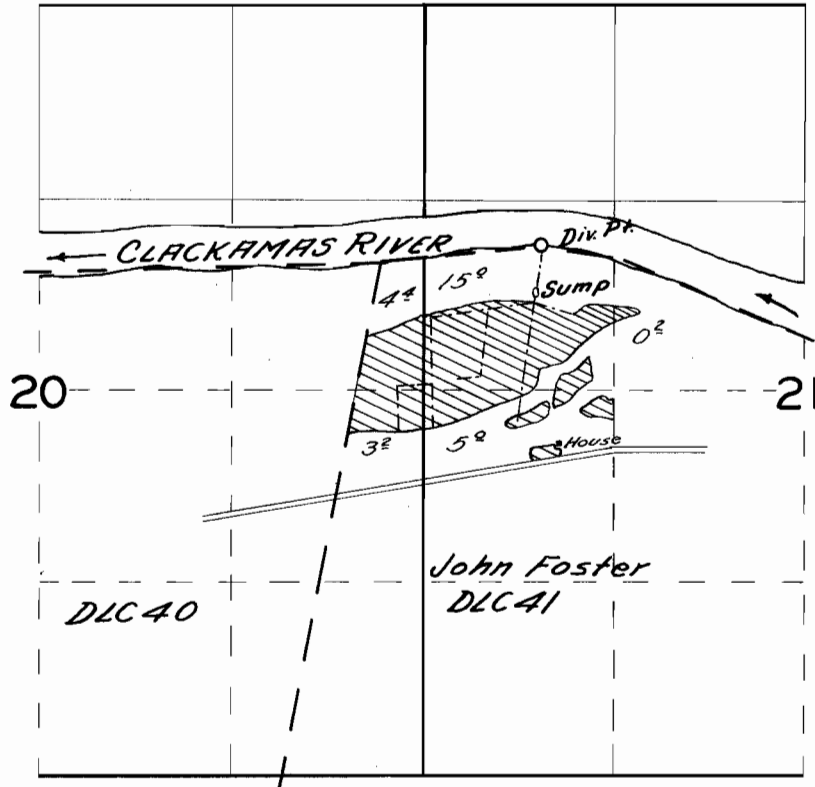

FINAL PROOF SURVEY
UNDER

Application No. 29649 Permit No. 23348
IN NAME OF

GEORGE FURKAWA

Surveyed June 29, 1956, by R.H. Whitby

DFK-10-135