T. 3S. R. 1W. W.M.

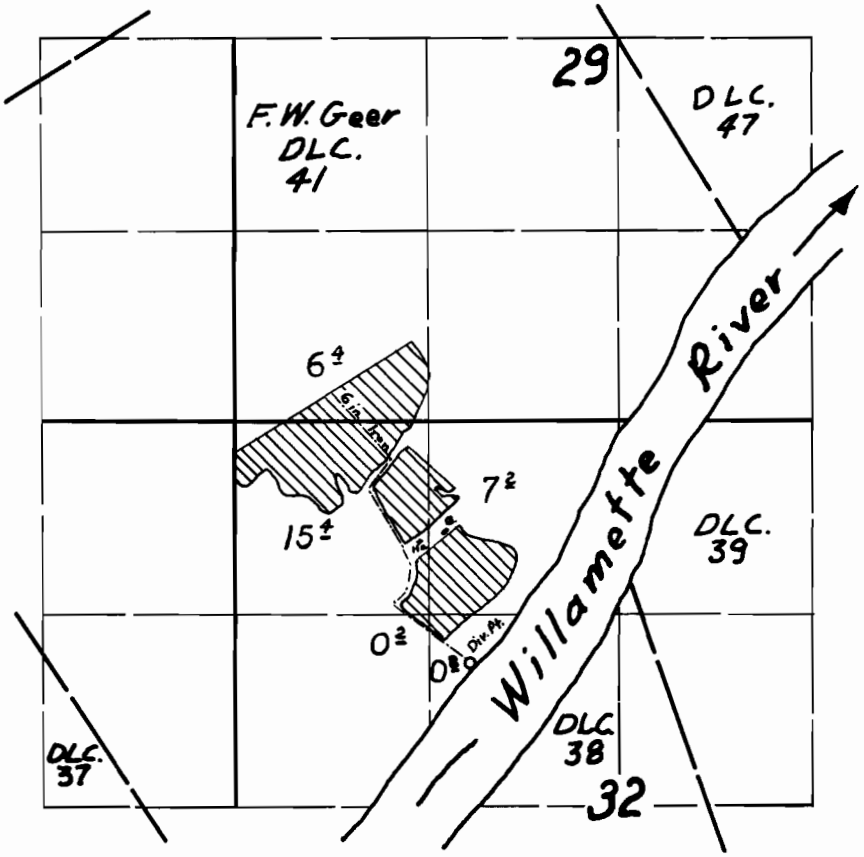

FINAL PROOF SURVEY

UNDER

Application No. 29916 Permit No. 23550

IN NAME OF

HENRY O. & BERNICE L. ENNEN

Surveyed 16 May 1956, by M. Bish

DFK-2D-43