


T 2 S. R. 4 E. W. M.

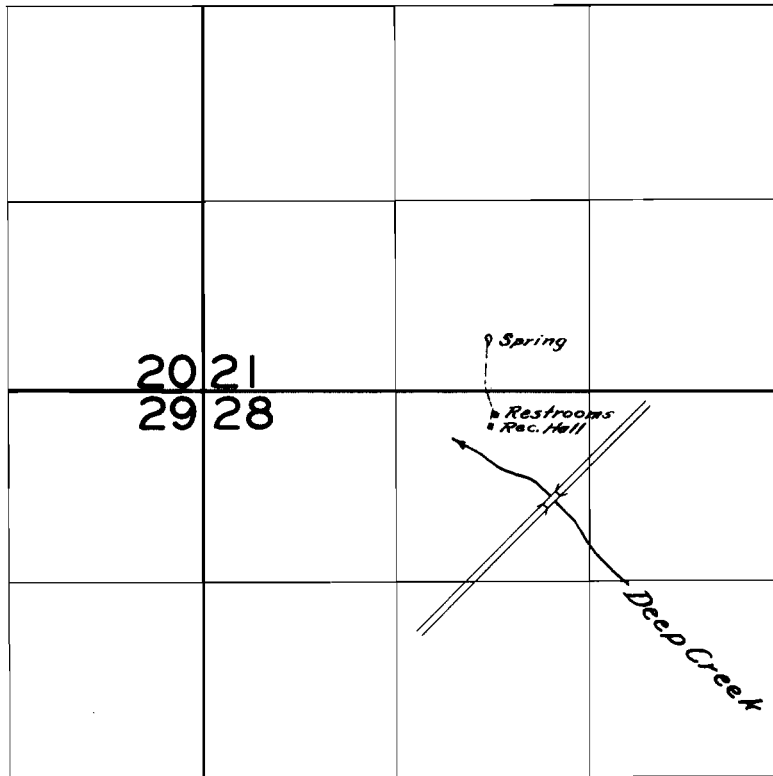

FINAL PROOF SURVEY

UNDER

Application No. *19545* Permit No. *15464*

IN NAME OF

*The City Extension Society of the
Methodist Episcopal Church of Portland*

Surveyed *June 22* 19*56*, by *R. H. Whitby*

DFK- 4D-16