


T. 78S. R. 40E.W.M.

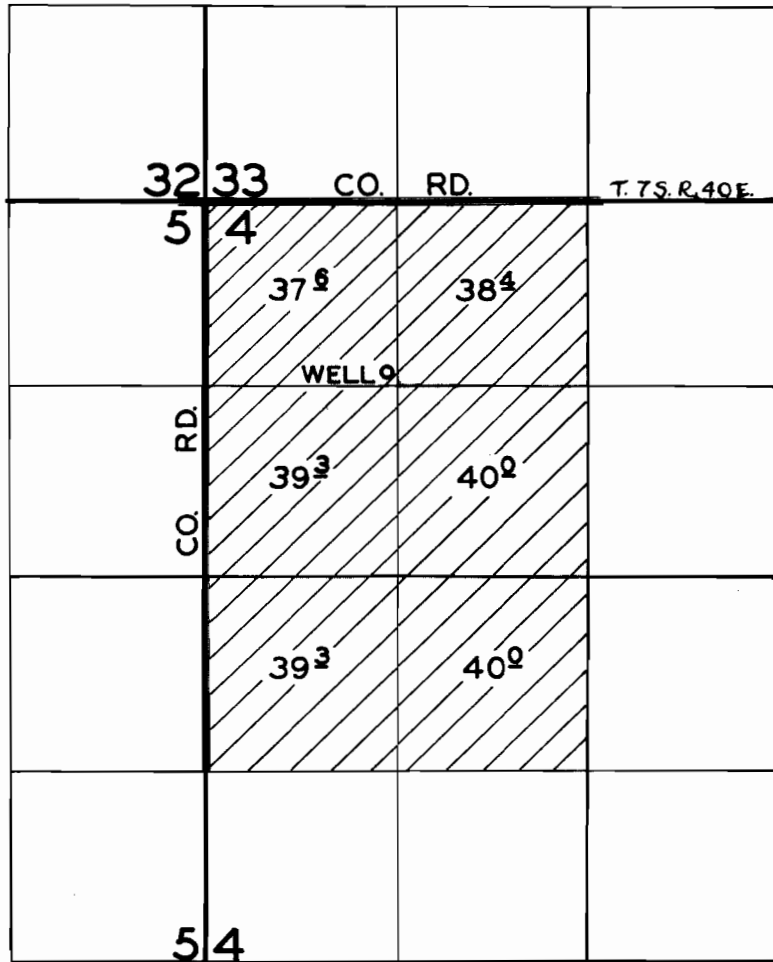

**FINAL PROOF SURVEY**

UNDER

Application No. U-450 Permit No. U-422

IN NAME OF

L. H. WILLIAMS

Surveyed 26 MAY 1956, by M. BISH

BBB-4N-128

*Print*