


T. 3 S. R. 1 E. W. M.

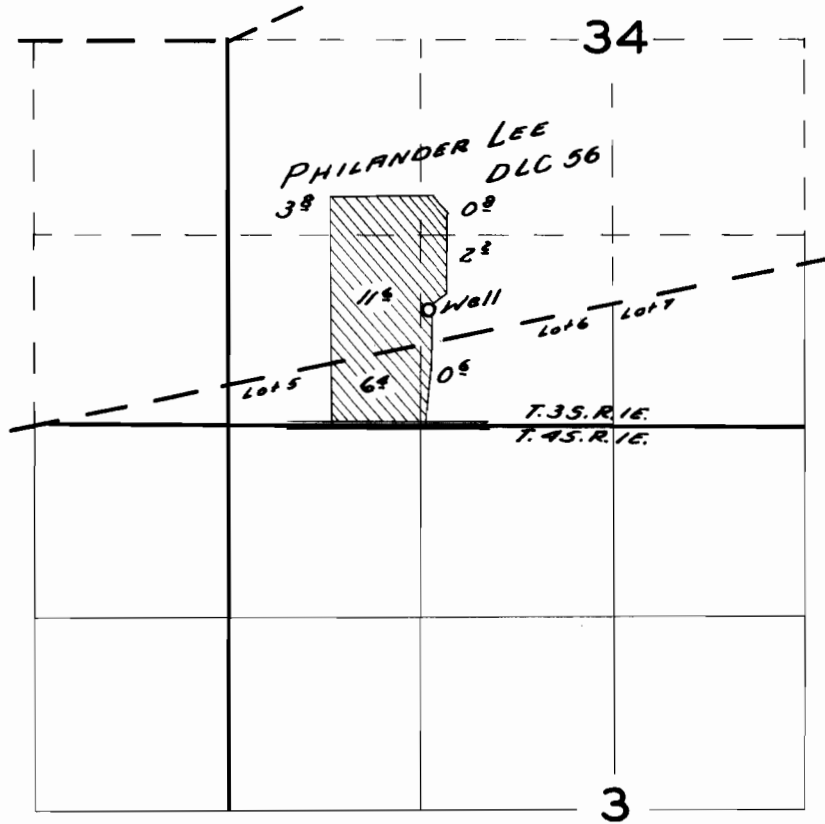

FINAL PROOF SURVEY
UNDER

Application No. 6340 Permit No. 6225
IN NAME OF

FRANK DEFORGE

Surveyed Sept. 26, 1956, by C.O. Bartels

DFK-30-52