


T. 5 S. R. 1 E. W.M.

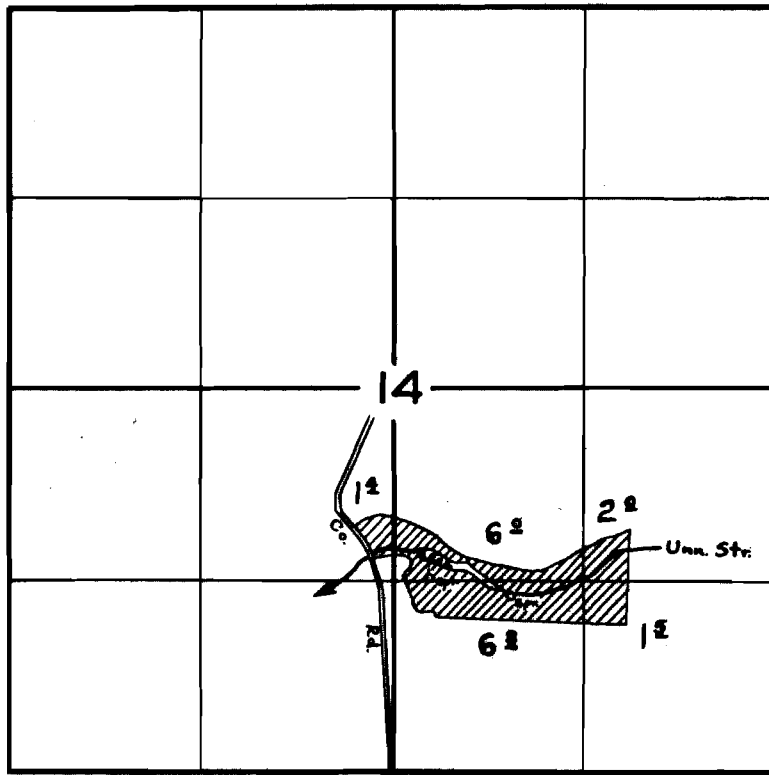

**FINAL PROOF SURVEY**

UNDER

**R21384**

**R-833**

Application No. **21385** Permit No. **16799**

IN NAME OF

**THEODORE FREEMAN**

Surveyed **21 MAR 1956**, by **R.D. BEST**

DFK - 3D - 89

*R.D.*