


T. 5 S. R. 1 E. W.M.

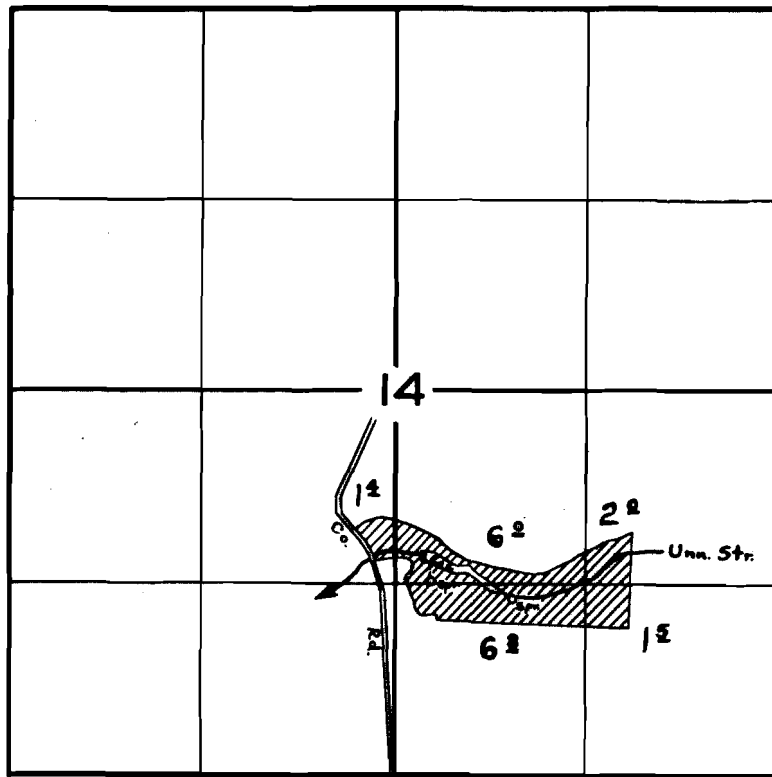

FINAL PROOF SURVEY

UNDER

R-21384

R-833

Application No. ~~21385~~ Permit No. ~~16799~~

IN NAME OF

THEODORE FREEMAN

Surveyed 21 MAR 1956 by R.D. BEST

DFK-3D-89

R.D.