


T.8S. R.3W.W.M.

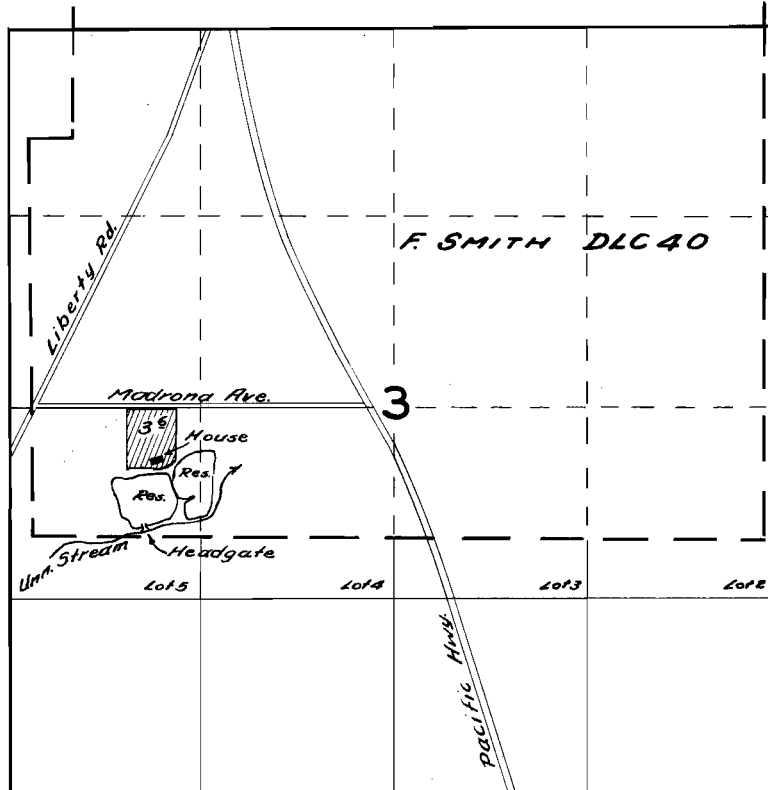

### FINAL PROOF SURVEY

UNDER

Application No. *R-22086* ~~22087~~ Permit No. *R-1119* ~~20178~~

IN NAME OF

*Fred W Berger*

Surveyed *June 1, 1956*, by *R.H. Whitby*