


T. 2 S., R. 2 W., W. M.

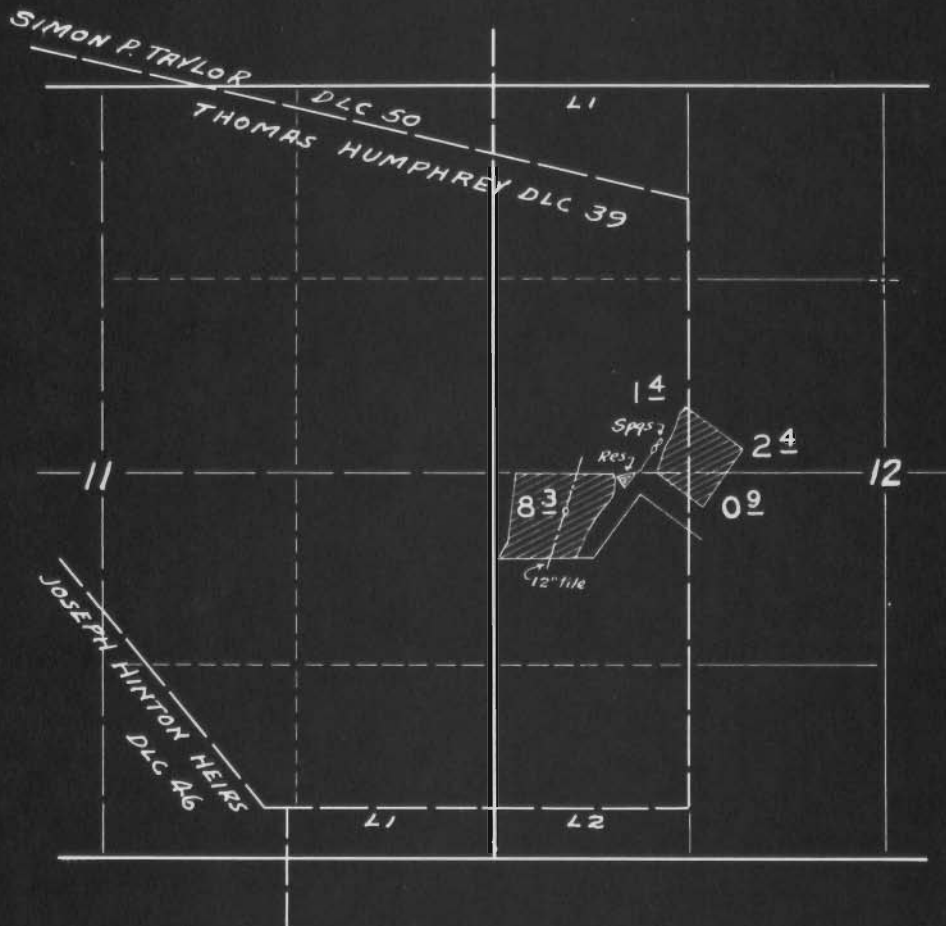

FINAL PROOF SURVEY

UNDER

R-25033

R-1190

Application No. 25034 Permit No. 20492

IN NAME OF

JOHN J. CARLSON

Surveyed 5 - 4 1956, by M. BISH