


T.7 S. R.1 E.W.M.

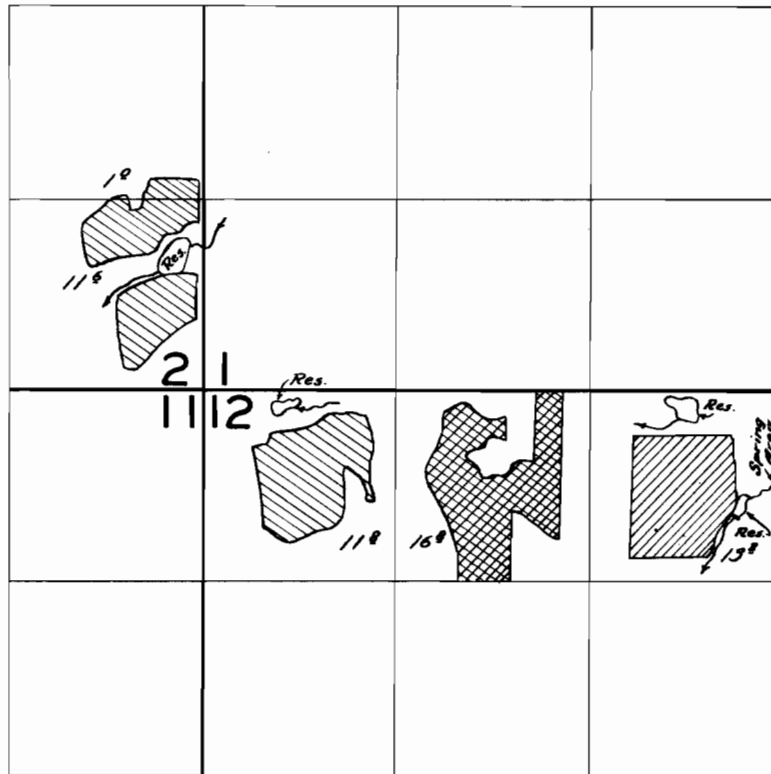

R-24375

R-25562

R-25562; Irrigated from Res. Under R-24375

FINAL PROOF SURVEY

Application No. *R-24375* Permit No. *R-1016*
24376 *19232*
R-25562 *R-1803*
25563 *20513*

IN NAME OF

Clyde McKillop
Ray McKillop

Surveyed *May 29/1956*, by *R.H. Whitby*