


T.7S. R.1E.W.M.

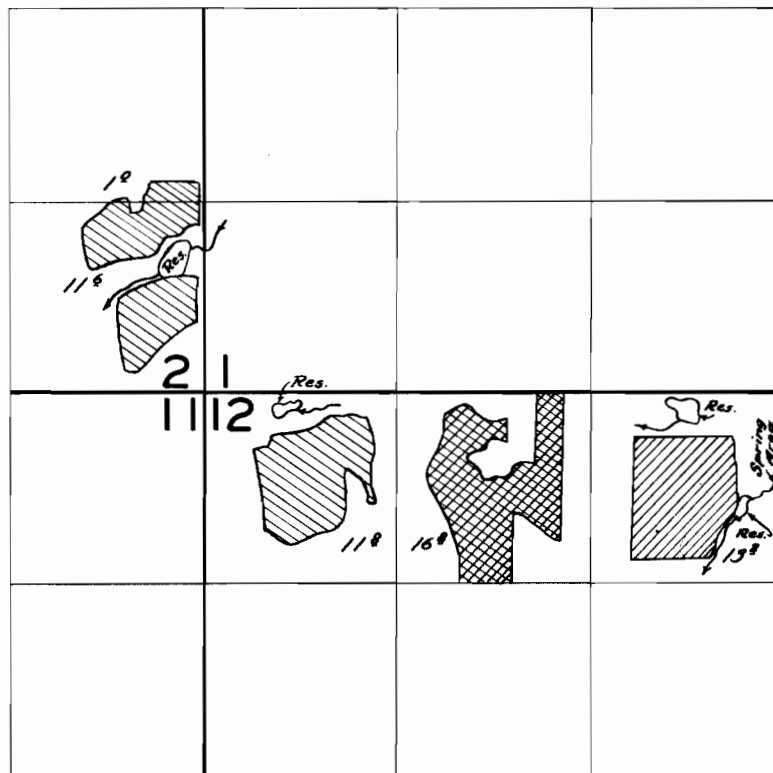

R-24375

R-25562

R-25562; Irrigated from Res. Under R-24375

FINAL PROOF SURVEY

Application No. R-24375 Permit No. R-1016
24376 19232
R-25562 R-1803
25563 20513

IN NAME OF

Clyde McKillop
Roy McKillop

Surveyed May 29/1956, by R.H. Whitby