


T. 1 S., R. 2 & 3 W., W.M.

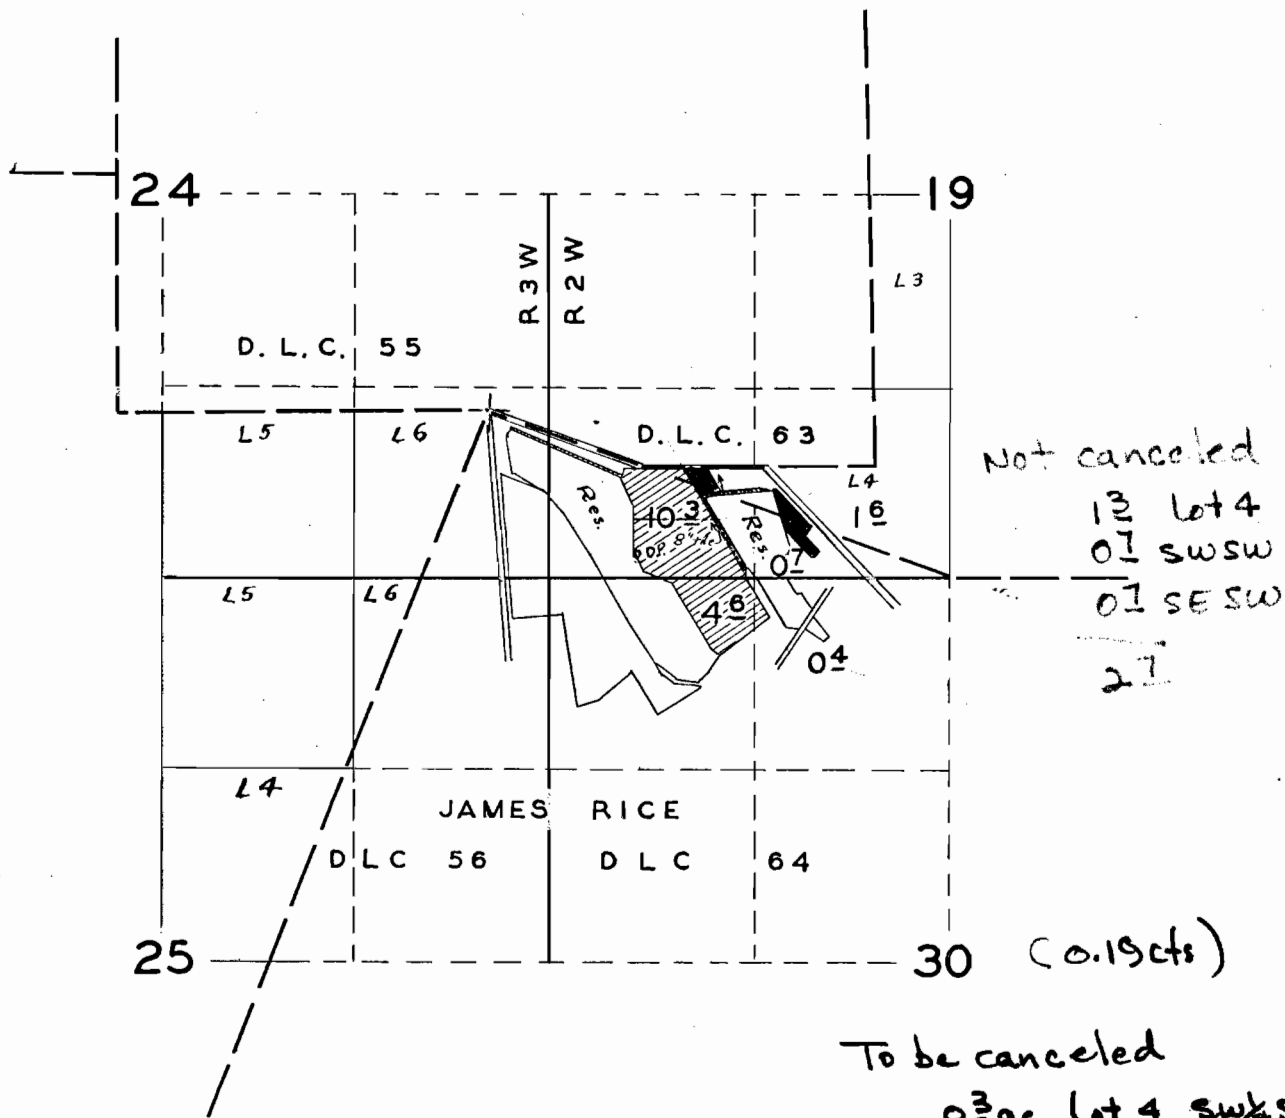

Not canceled
 13 lot 4
 01 ssw
 01 se sw
 27

To be canceled
 03 ac lot 4 sw 1/4 sw 1/4
 96 ac. sw 1/4 sw 1/4
 w/in DLC 64
 See 19
 04 NEX 1/4 NW 1/4
 46 NW 1/4 NW 1/4
 both w/in DLC 64
 See 30

FINAL PROOF SURVEY

UNDER

R-25619

R-1205

Application No. 25962 Permit No. 20547

IN NAME OF

GEORGE & EDWIN E. BURKHALTER

Surveyed 4-25 1956, by M. BISH

T. 1 S., R. 2 W., W.M.