


T. 3S. R. 2E. W.M.

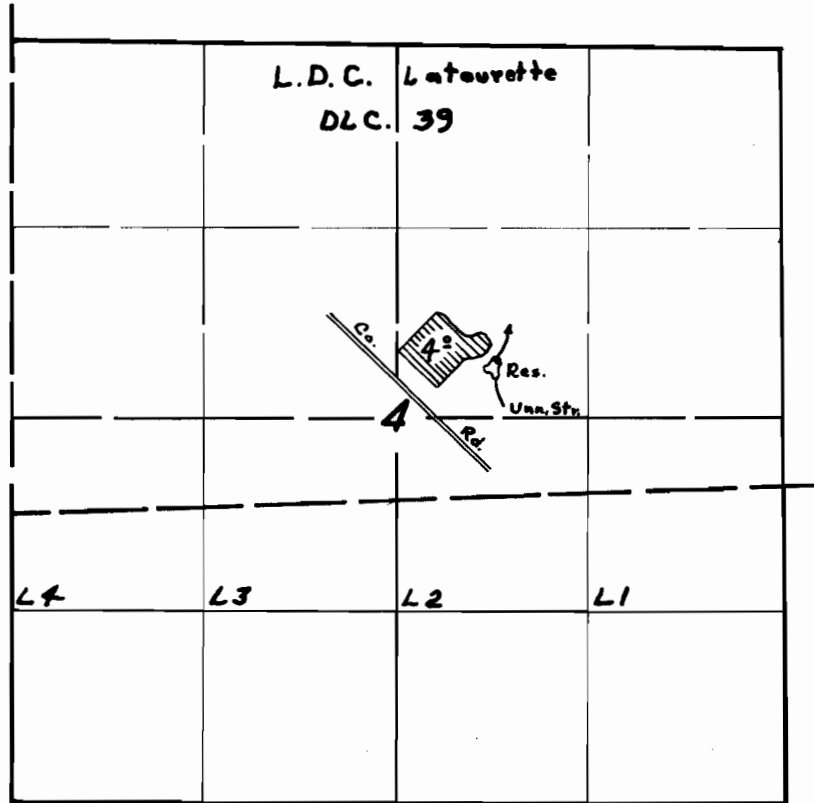

FINAL PROOF SURVEY

UNDER

R-26688

R-1286

Application No. ~~26689~~ Permit No. ~~20894~~

IN NAME OF

C. J. MONTAGNE

Surveyed 21 June 1956, by M. Bish

DFK-3D-149

2005