


T. 7 S. R. 1 E. W. W.

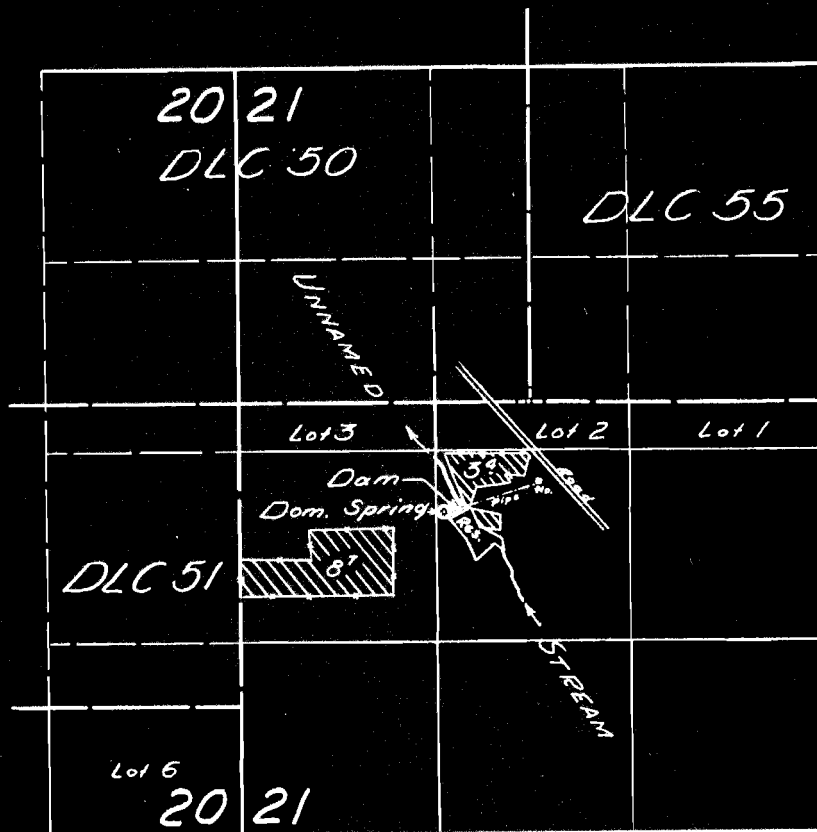

FINAL PROOF SURVEY

UNDER

R-26468

R-1311

Application No. 26469 Permit No. 21004

IN NAME OF

EDWARD J. MARTIN

Surveyed 25 May 1950, by C. H. Whitley

1956-W