


T.7S.R.1E.W.W.

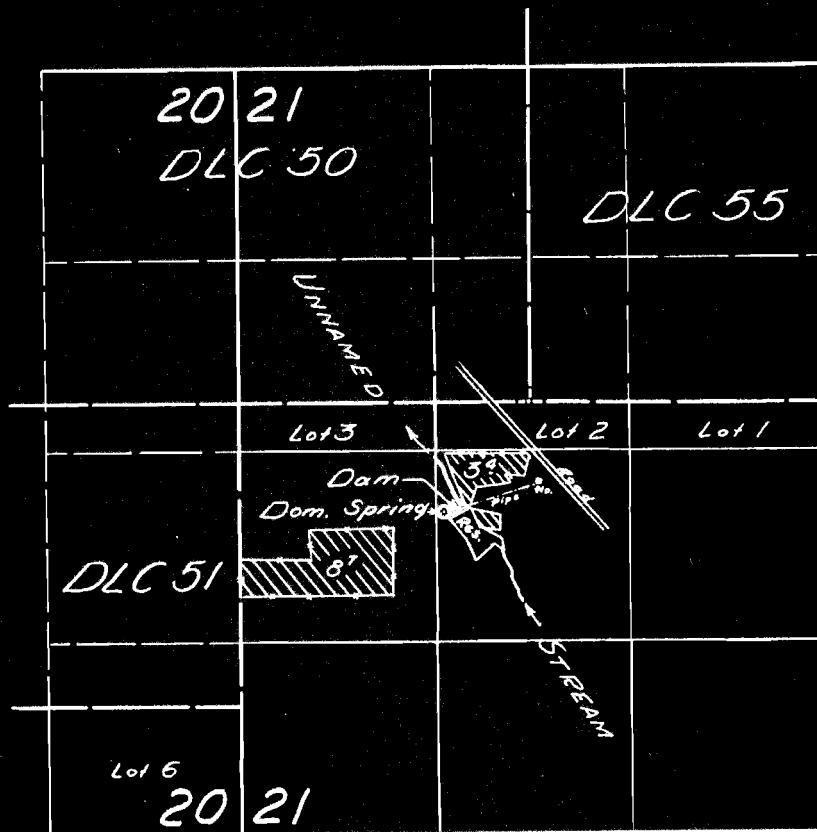

FINAL PROOF SURVEY

UNDER

R-26468

R-1311

Application No. 26469 Permit No. 21004

IN NAME OF

EDWARD J. MARTIN

Surveyed 25 May 1956, by *E. J. Martin*