


T. 2S., R. 1W., W.M.

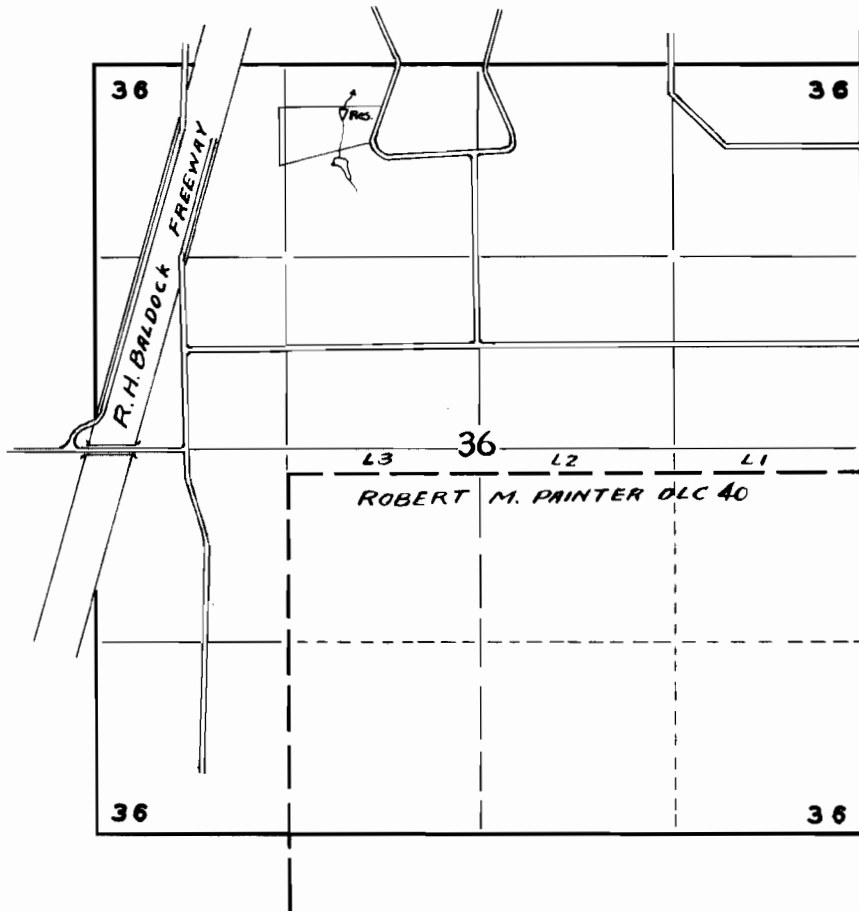

FINAL PROOF SURVEY

UNDER

R-26906

R-1335

Application No. 26907 Permit No. 21142

IN NAME OF

ERNEST W. RICHTER

Surveyed 5 - 4 1956, by R.H. WHITBY