


T. 9 S. R. 3 W. W. M.

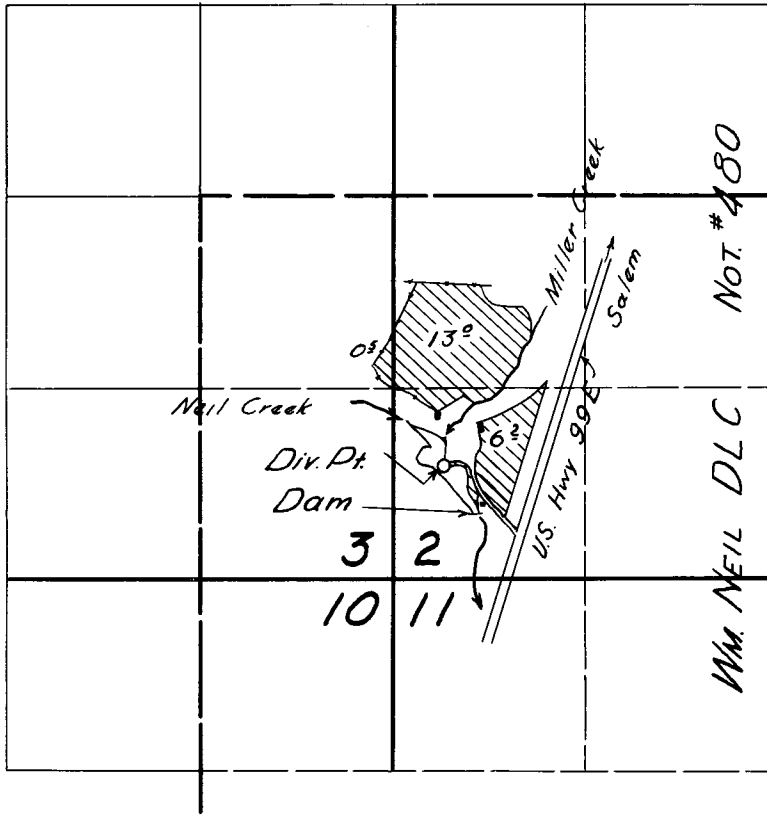

FINAL PROOF SURVEY

UNDER

27799

21989

Application No. R-27798 Permit No. R-1470

IN NAME OF

ASEL C. EOFF

Surveyed 15 May 1956, by [Signature]