


T. I. S., R. 2 & 3 W., W.M.

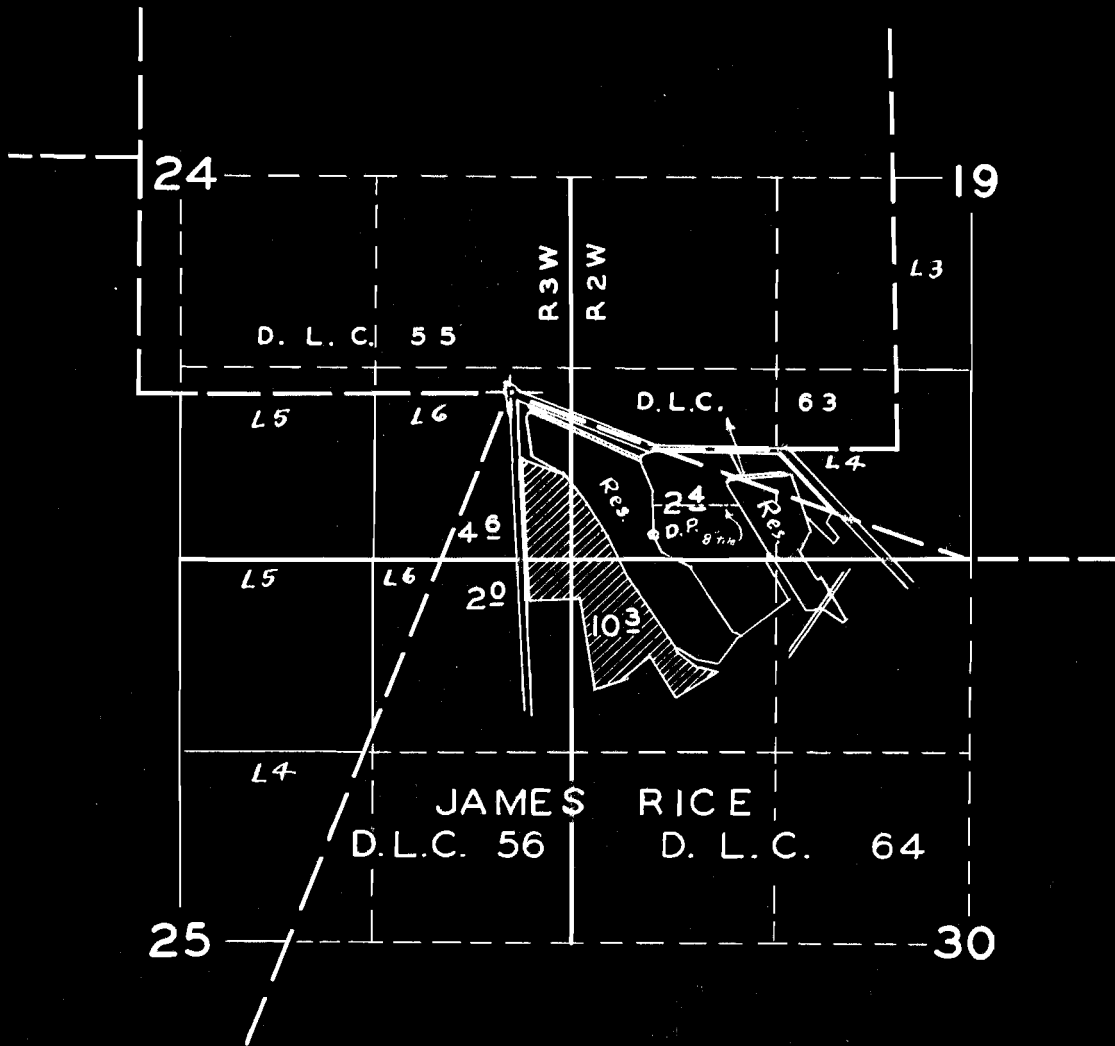

FINAL PROOF SURVEY

UNDER

R-28100

R-1518

Application No. 28645 Permit No. 22470

IN NAME OF

BURKHALTER BROTHERS

Surveyed 4-25 1956, by M. BISH