T. 3S. R. 2E. W.M.

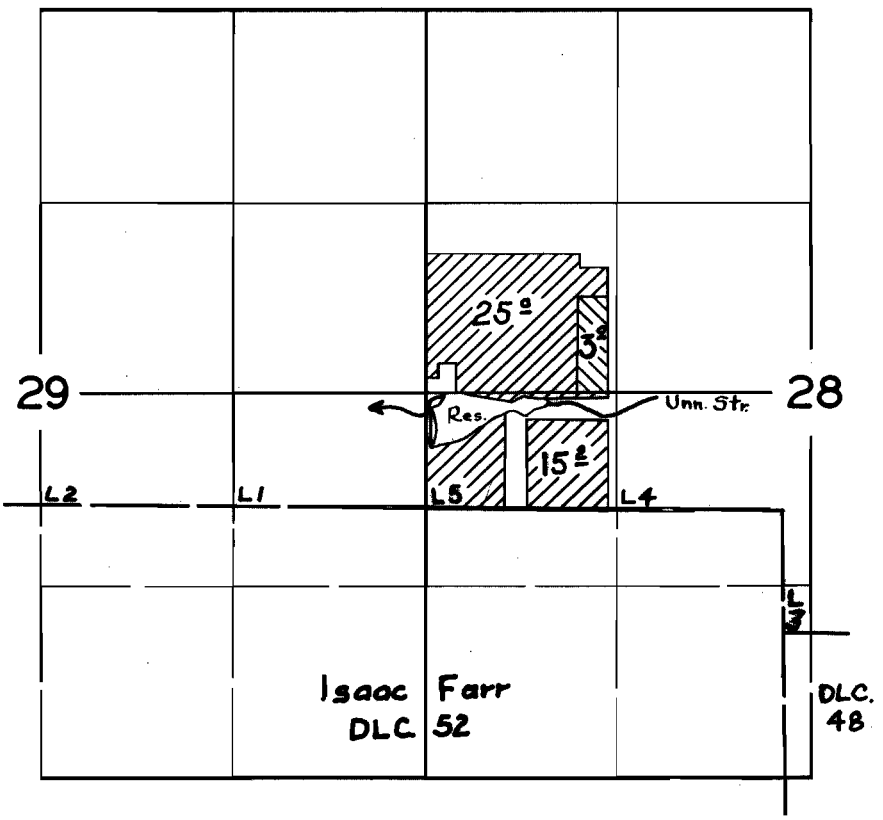

FINAL PROOF SURVEY

R-26433 26434 UNDER R-28927 R-1254 20729 R-1565

Application No. 28945 Permit No. 22630

IN NAME OF

FLORENCE L. MUELLER

Surveyed 21 June 1956, by M. Bish

DFK-3D-153