


T.2S.,R.3W., W.M.

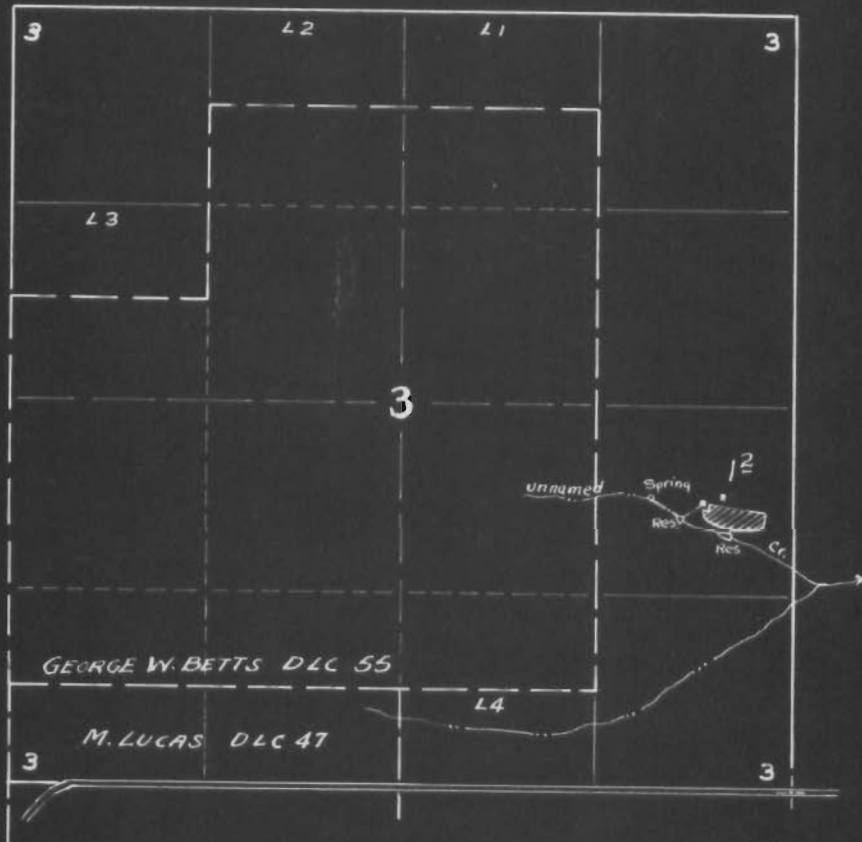

FINAL PROOF SURVEY

UNDER

R-29090

R-1619

Application No. 29091

Permit No. 22915

IN NAME OF

D. P. CHAMBERS

Surveyed 4-27 1956, by R.H. WHITBY