


T. 8 S. R. 46 E. W.M.

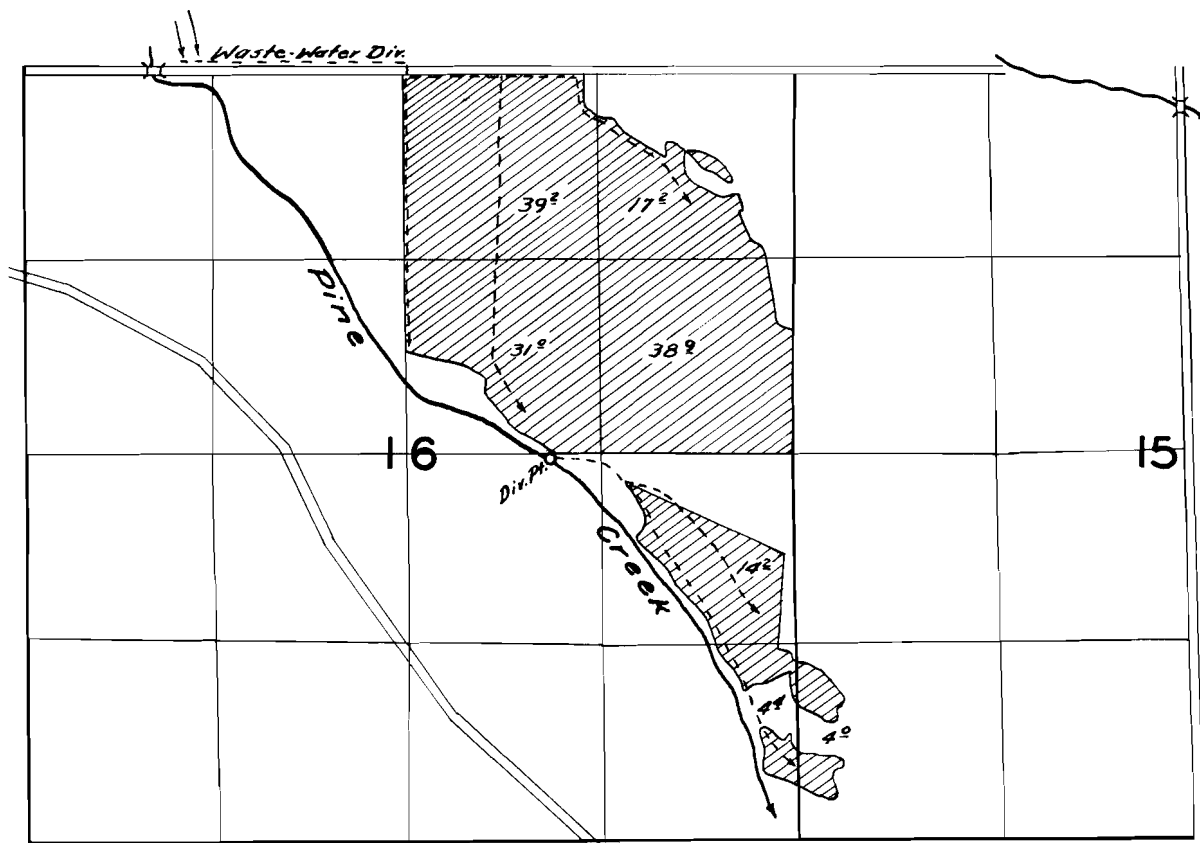

FINAL PROOF SURVEY

UNDER

Application No. *20397* Permit No. *15911*.....

IN NAME OF

E.K. Greener & Ed R. Greener.....

Surveyed *Oct. 15* 1956, by *M. Bisk*.....

BBB-9N-135