


T. 3 N., R. 3 W., W.M.

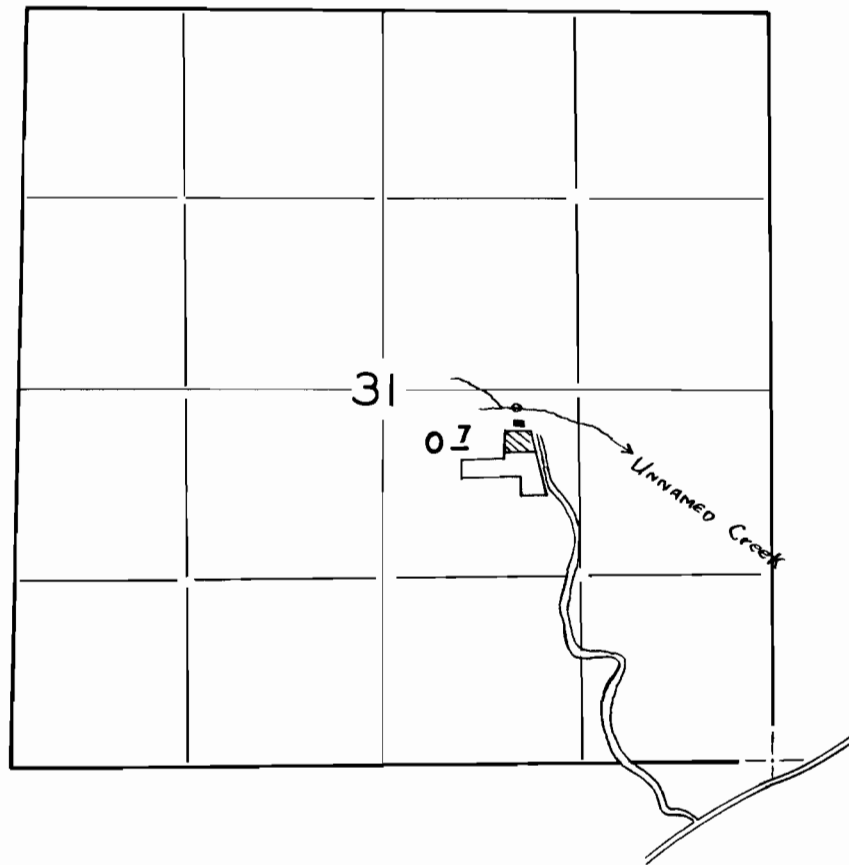

FINAL PROOF SURVEY

UNDER

Application No. 24067 Permit No. 20949

IN NAME OF

GEORGE J. ZEH

Surveyed 4 - 10, 1956, by R. H. WHITBY