


T. 9S. R. 4W. W.M.

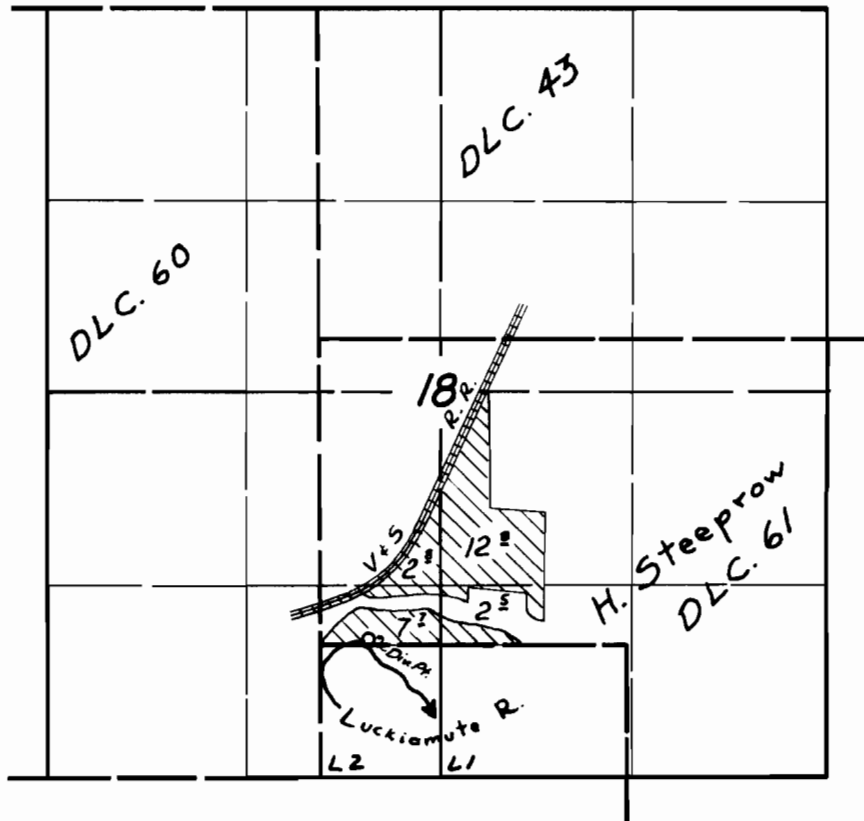

FINAL PROOF SURVEY

UNDER

Application No. 22985 Permit No. 18191

IN NAME OF

BESSIE SPARKS

Surveyed 14 Aug. 1956, by R. H. Whitty