


T. I. S., R. I. W., W. M.

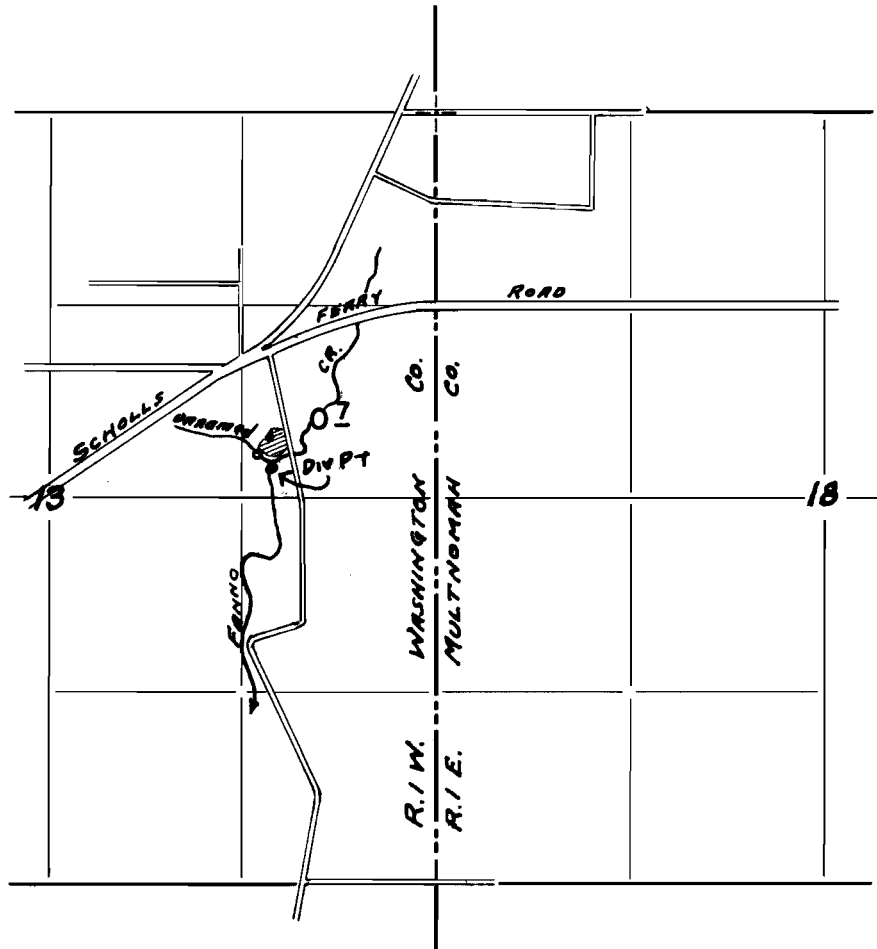

**FINAL PROOF SURVEY**

UNDER

Application No. 23213 Permit No. 18278

IN NAME OF

CHARLES A. & MARY E. ROSS

Surveyed 4 - 16 1956, by M. BISH