


T. 4S. R. 2W. W.M.

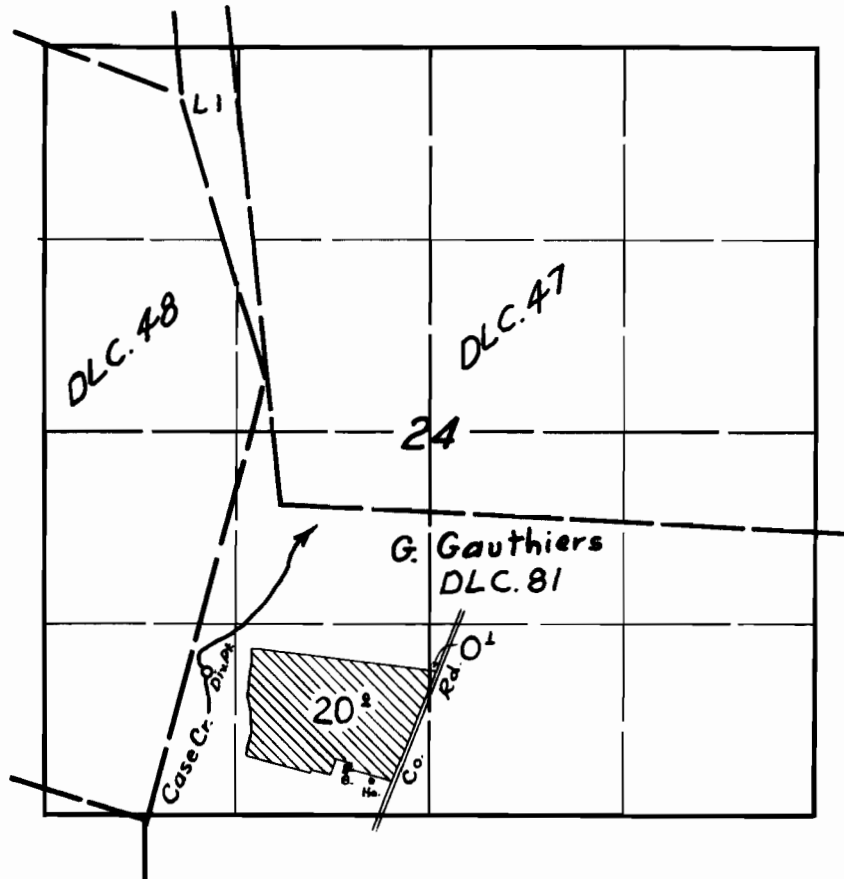

FINAL PROOF SURVEY

UNDER

Application No. 22989 Permit No. 18192

IN NAME OF

I.O. WILLIAMSON

Surveyed 21 Sept. 1956, by M. Bish

DFN-20-98

RWS