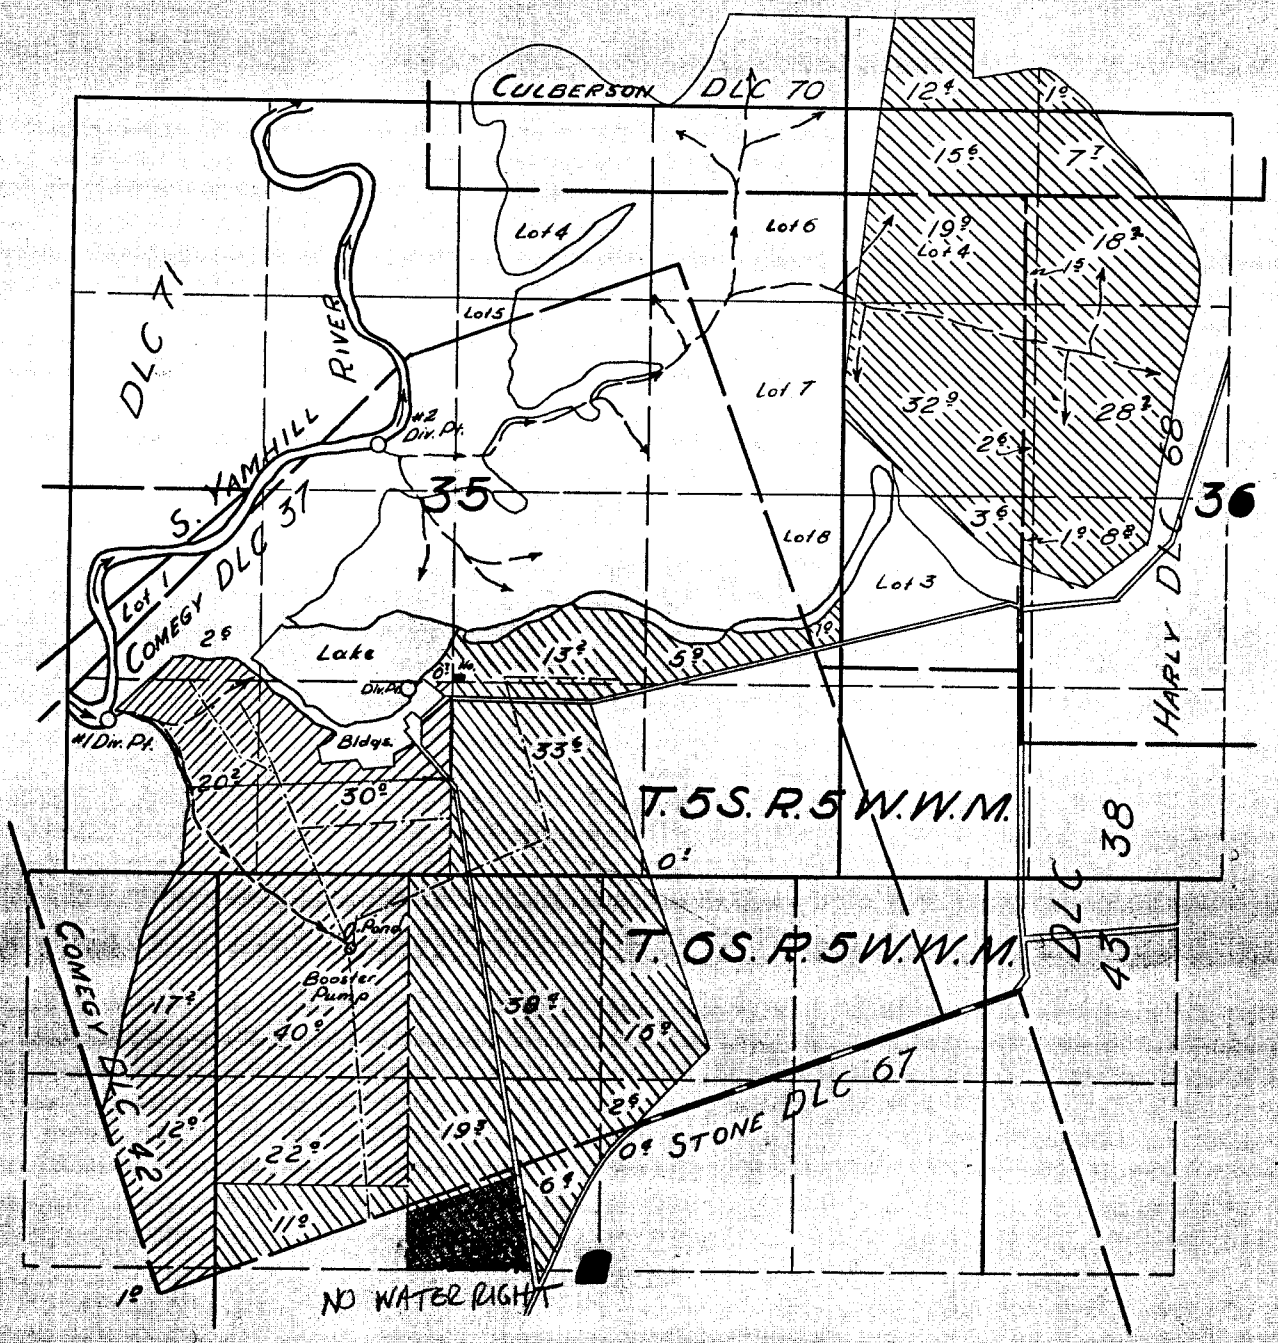

FINAL PROOF SURVEY

UNDER

17634 14690

Application No. 20653 Permit No. 18862

IN NAME OF

H. M. HAWKINS

Surveyed 22 Mar 1956, by A. B. Whitby

DFQ-40-103