


T. 2 S. R. 5 E. W. M.

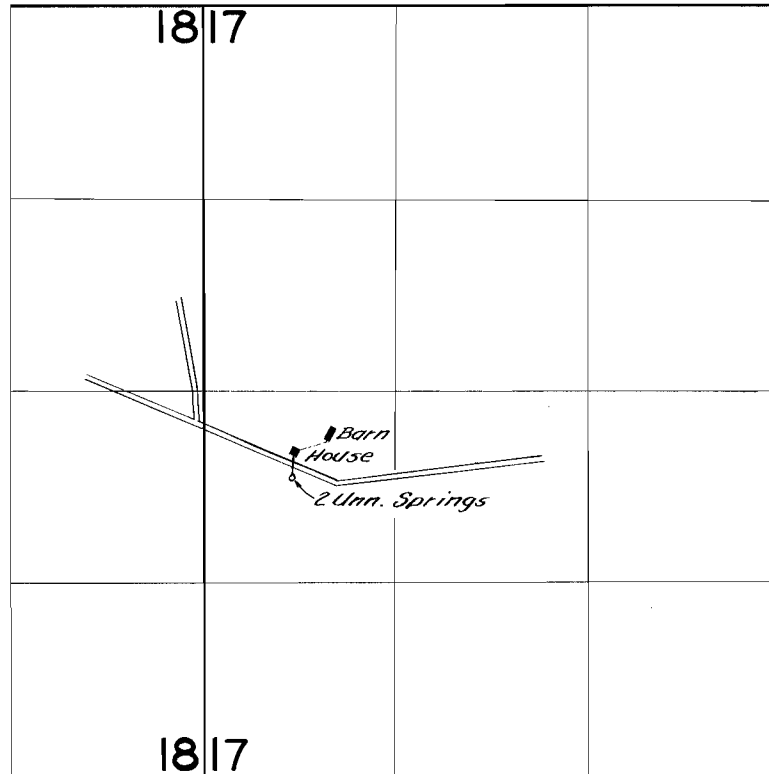

FINAL PROOF SURVEY

UNDER

Application No. 23194 Permit No. 18297
IN NAME OF

Robert D. Buckel

Surveyed June 14, 1956, by R.H. Whitby

DFK-4D-78

C.R.