


T.6S.R.1W.W.M.

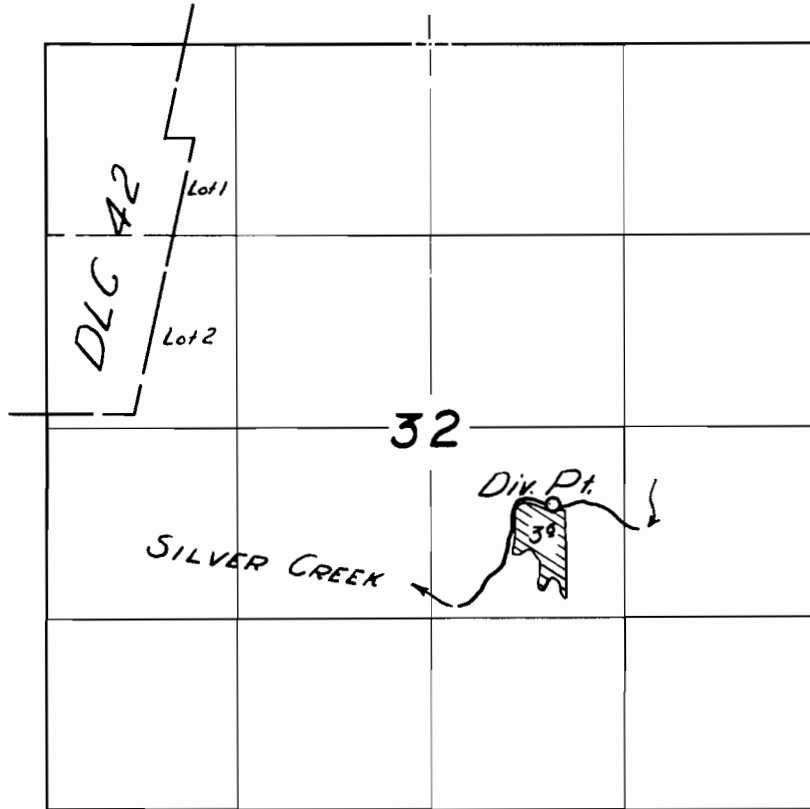

**FINAL PROOF SURVEY**  
UNDER

Application No. 23965 Permit No. 18915  
IN NAME OF

OSCAR STRAND

Surveyed 6 June 1956, by [Signature]