


T. 7 S. R. 1 W. W.M.

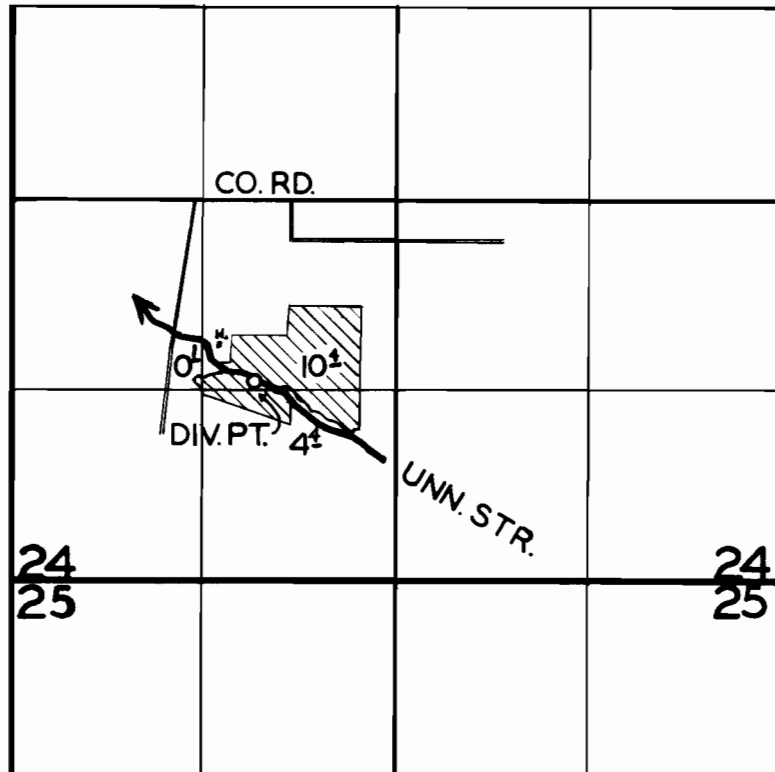

FINAL PROOF SURVEY

UNDER

Application No. 23979 Permit No. 18920

IN NAME OF

NOAH HUNT

Surveyed 1 MAR. 1956, by M. BISH