


T. 1 N., R. 1 W., W.M.

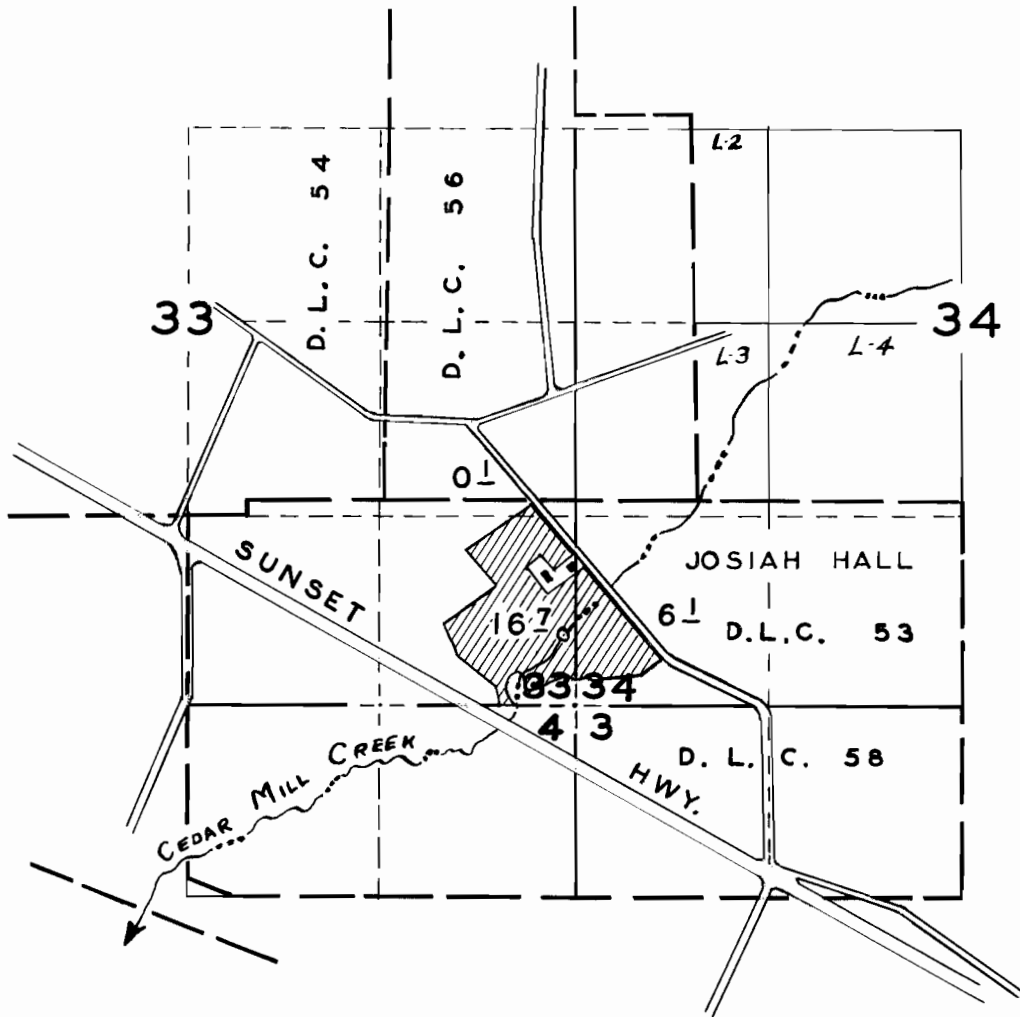

FINAL PROOF SURVEY

UNDER

Application No. 24541 Permit No. 19316

IN NAME OF

ESTATE OF ALFRED GRUNBAUM

Surveyed 4 - 9 1956, by M. BISH