


T. 6 N. R. 2 W. W. M.

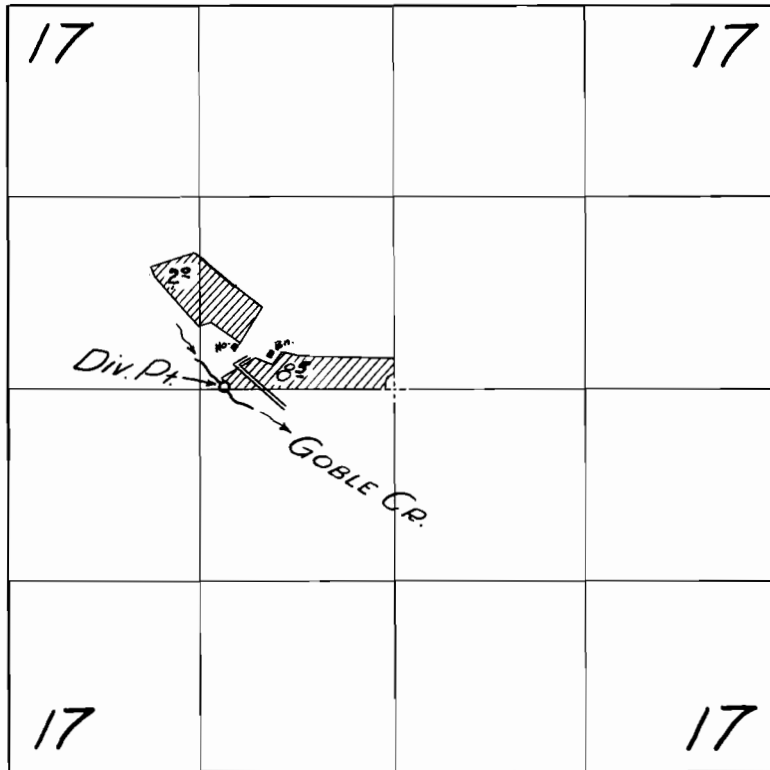

FINAL PROOF SURVEY
UNDER

Application No. 24610 Permit No. 19383
IN NAME OF

ROLLO R. SCHIMMEL

Surveyed 7 Aug 1956, by [Signature]