

18 17  
19 20


S 89° 25' E

2558.8'

N 80° 25' W  
692.3

378° 22' W 2" Galvanized Iron Pipe 7  
596.8  
571° 44 1/2' W  
794.8

S 85° 04' E  
1937.3

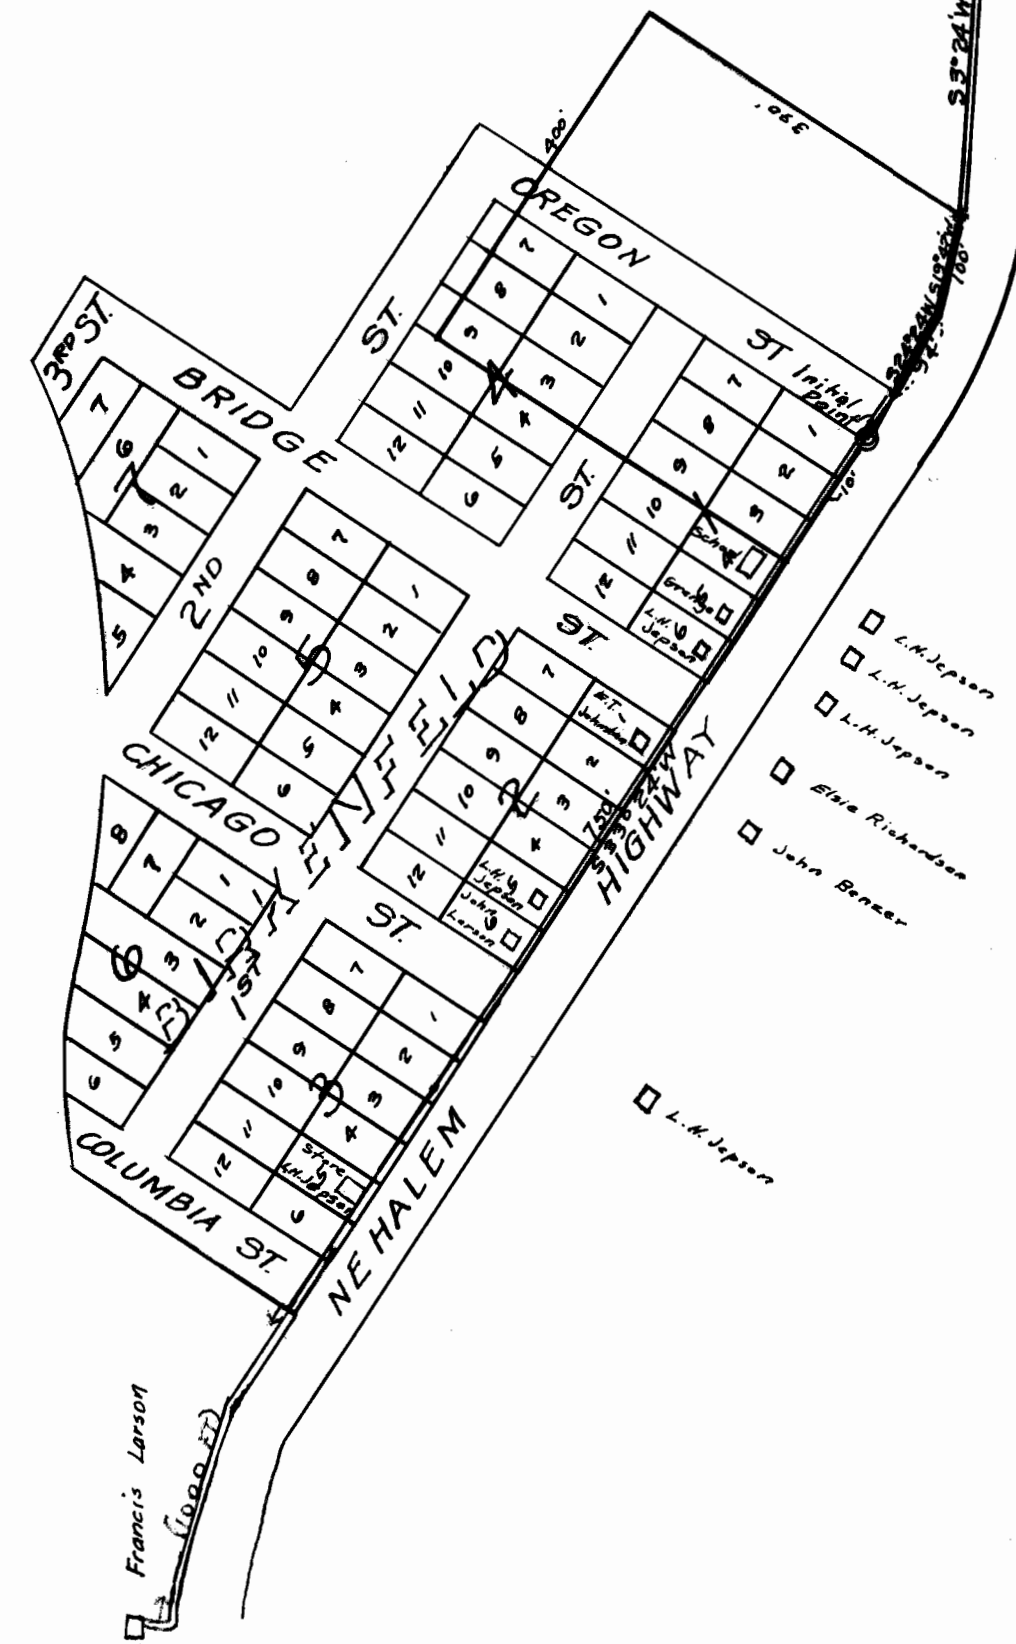

- L.H. Jepson
- L.H. Jepson
- L.H. Jepson
- Eliza Richardson
- John Bence
- L.H. Jepson

Note: Houses shown are to be hooked up to water system.



**BIRKENFELD WATER LINE**  
**L.H. JEPSON & OTHERS**  
 SECTION 17 & 20, T6N, R5W.  
 COLUMBIA COUNTY OREGON  
 Scale 1" = 200' March 1950



24621  
19468