

SURVEY FOR J. R. KAY


Route 3, Box 313

Hillsboro, Oregon

In Section 7, T2N, R2W, W.M.,

Washington County,
Oregon.

Scale 1" = 300'

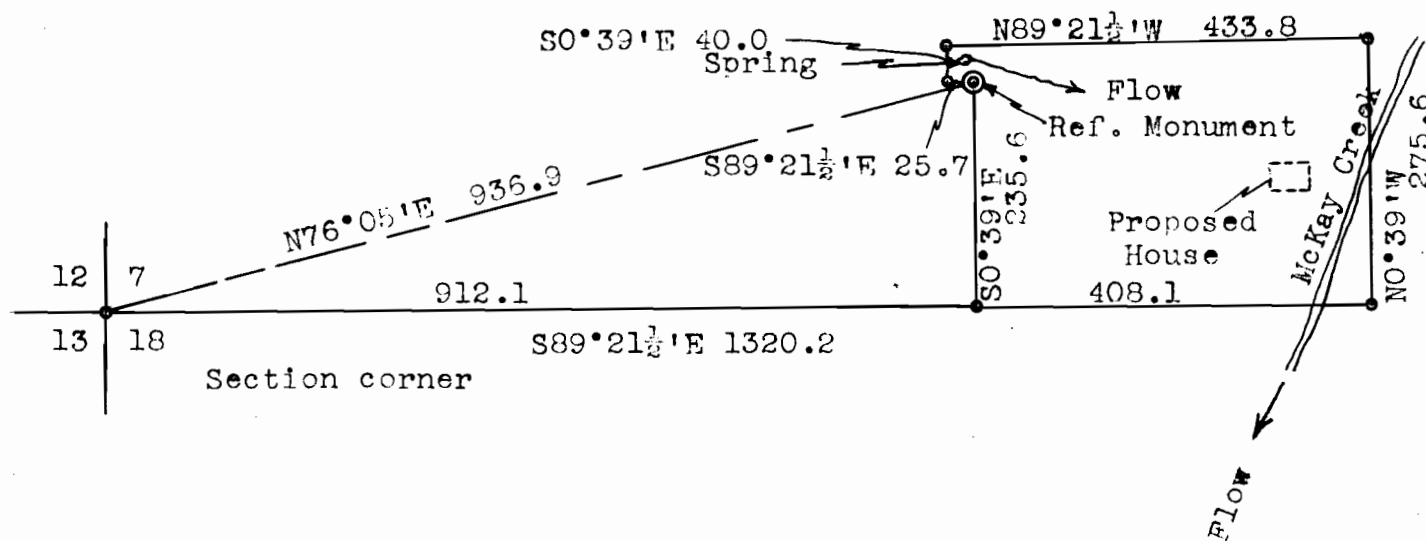

I, L. L. MacIntyre of Hillsboro, Oregon, do hereby certify that this map was made from notes taken during an actual survey made by me on March 3, 1950; that the monument shown on this map consisting of a 1½" x 36" iron pipe driven 30" into the ground is N76°05'E 936.9 from the southwest corner of section 7, T2N, R2W, W.M., Washington County, Oregon.



Application No. 24651
Permit No. 19476