


T. 3 S., R. 2 W., W.M.

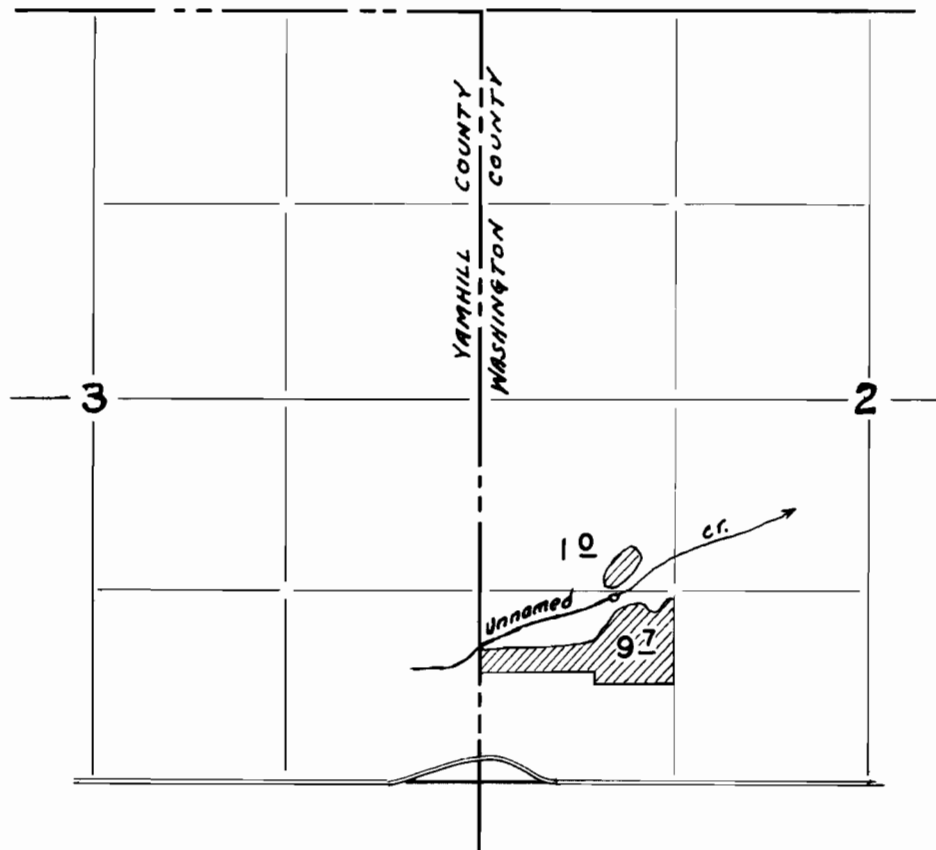

FINAL PROOF SURVEY

UNDER

Application No. 24842 Permit No. 19555

IN NAME OF

J. R. BLAKE

Surveyed 5 - 9 1956, by M. BISH