


T. 5S. R. 2E. W.M.

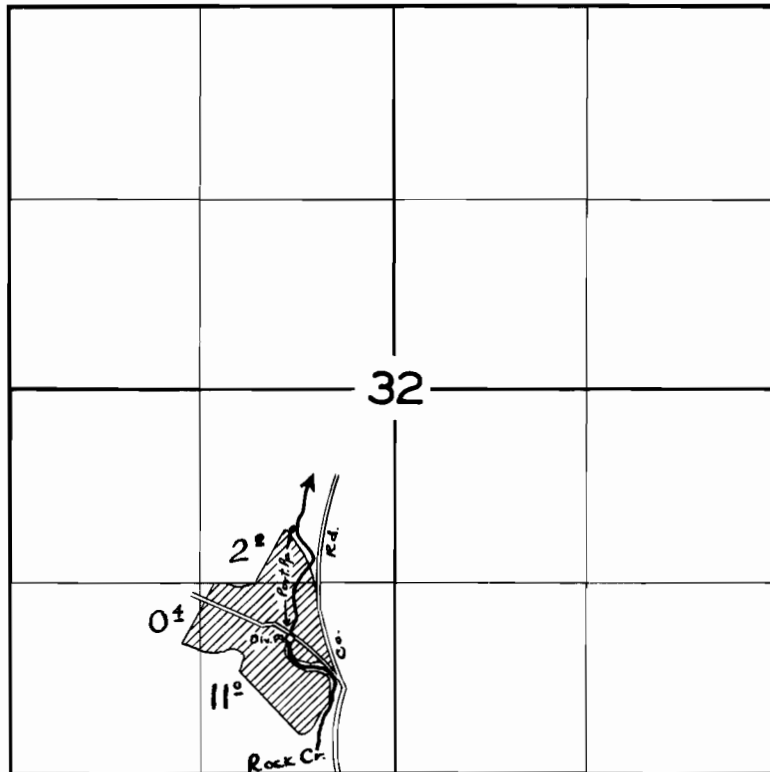

FINAL PROOF SURVEY
UNDER

Application No. **25031** Permit No. **19720**
IN NAME OF

ALBERT OLSEN

Surveyed **28 MAR 1956**, by **R.D. BEST**