


T 2S. R. 2E. W.M.

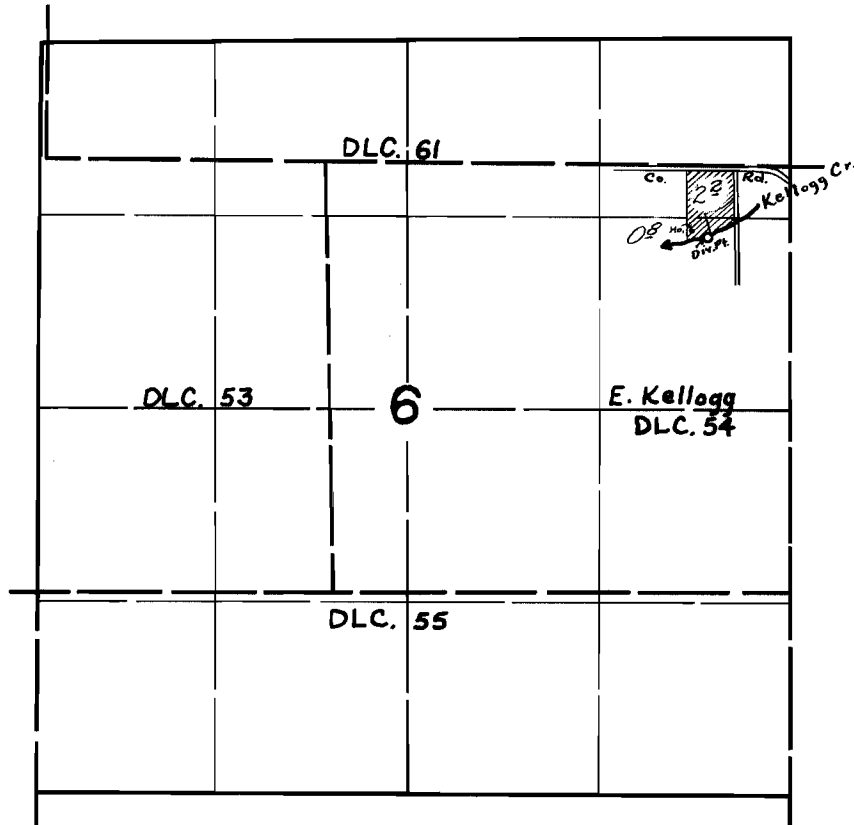

FINAL PROOF SURVEY

UNDER

Application No. 25155 Permit No. 19787

IN NAME OF

George Churchill Cook & Lee M. Rhoads

Surveyed 15 May 1956, by M. Bish