


T. 1 S., R. 2 W., W.M.

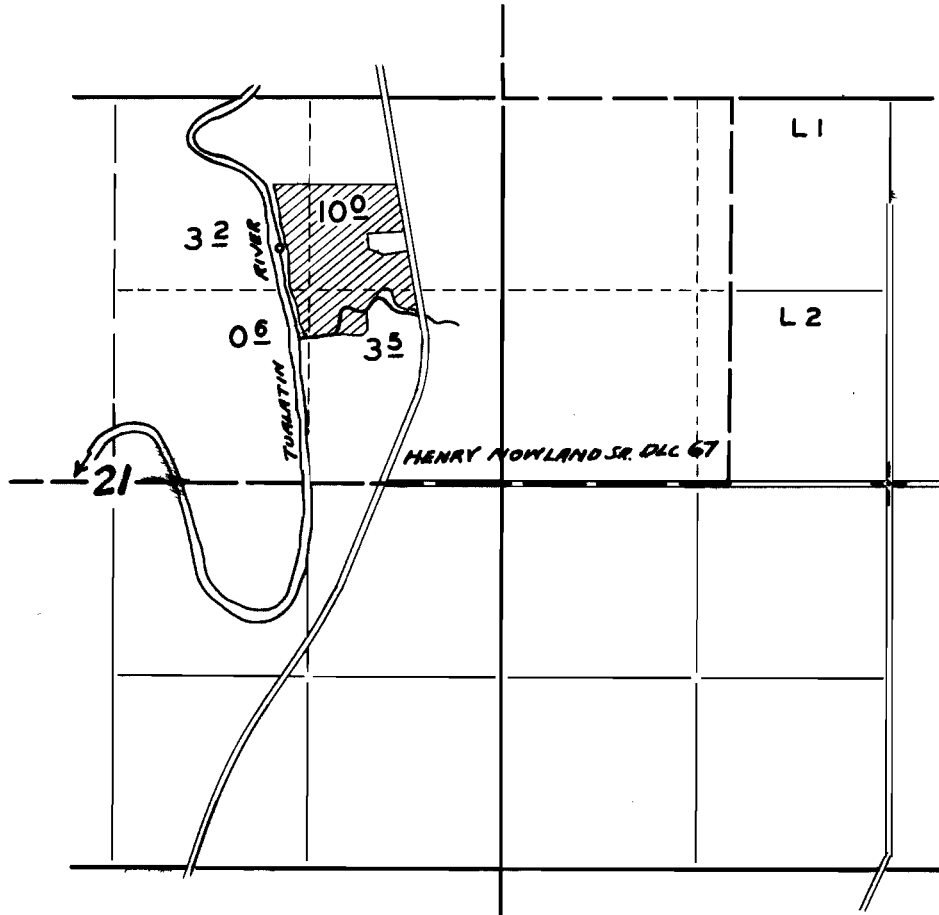

FINAL PROOF SURVEY

UNDER

Application No. 25291 Permit No. 19855

IN NAME OF

EARL L. & LULU JOHNSON

Surveyed 4 - 18 1956, by M. BISH