


T. 4 S. R. 1 W. W. M.

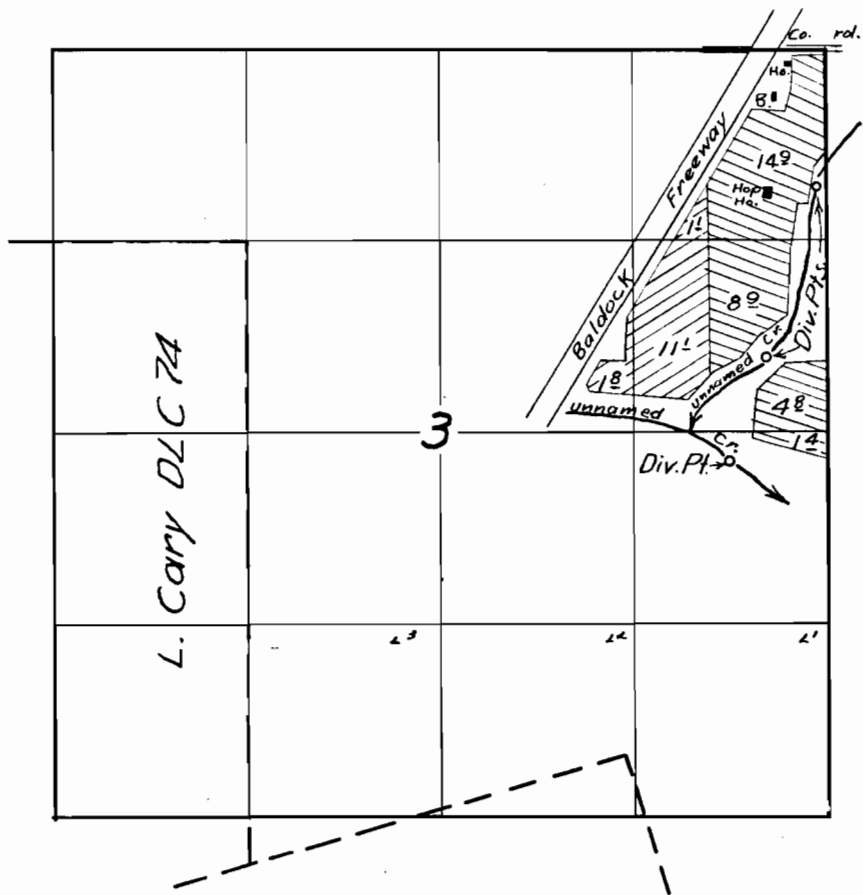

FINAL PROOF SURVEY

UNDER

Application No. ²⁴²⁹⁴ ~~25422~~ Permit No. ¹⁹²²⁰ ~~20001~~

IN NAME OF



Mary Lofgren

Surveyed 21 Sept. 1956, by Tr. Bish