


T.2S. R.1W. W.M.

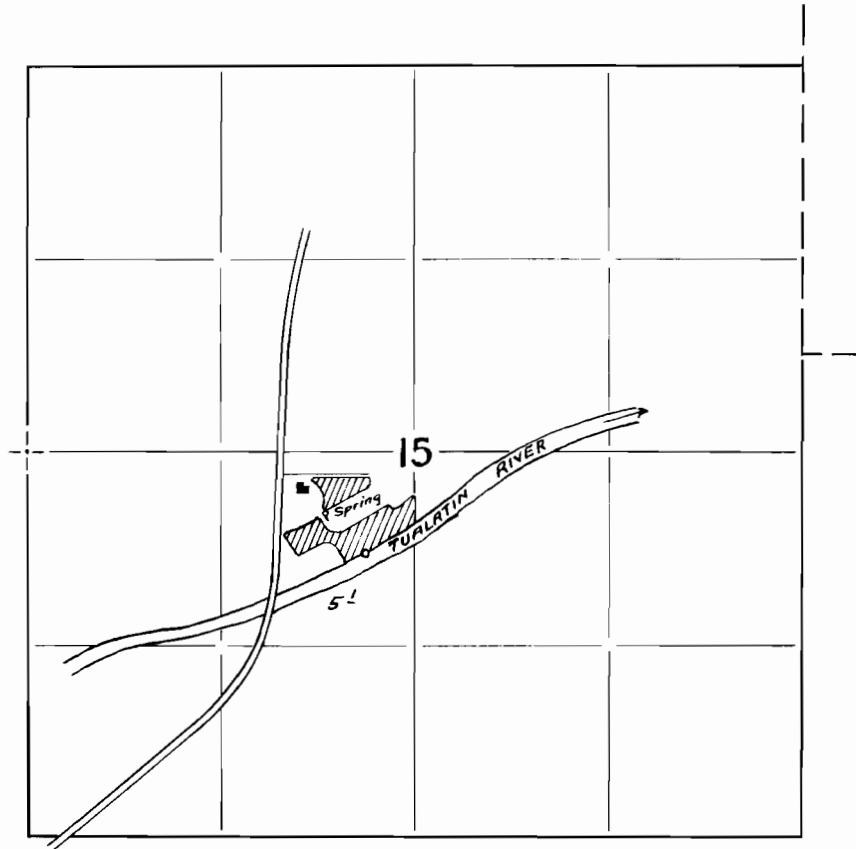

FINAL PROOF SURVEY
UNDER

Application No. 25532 Permit No. 20055
IN NAME OF

JOHN H. FREDERICK

Surveyed 5 - 9 1956, by R.H. WHITBY